

CERTIFIED RECORD OF LAND CORNER MONUMENTATION

INDEX No. V-9

History of original corner establishment:

Corner originally established in 1873, by Zenas F. Moody, under General Land Office Contract No. 184. Surveyor General's Notes State: Set post in earth mound for cor. to Secs. 32-38-28 & 29, From which:
A Pine 10 in. diam. bears N85°W., 10 lks.
A Pine 12 in. diam. bears S15°E., 10 lks.

DIAGRAM	
T4S R28E	
S291S28	

S321S33	
1984	
PLS 848	

In 1937, Morrow County Surveyor, H. Tambllyn, found a mound of stone. His notes state: Find mound of stones 3.49 ch. North of line. This mound was almost covered with earth and sod, but this area having been burned over I could find no evidence of bearing trees. Found old blazed line running South from this mound. I accepted this as

Description of corner evidence found:

Found an old stone mound as called for by H. Tambllyn with remains of post in center, under mound. It is felt that the original notes are in error, when calling for the earth mound.


Found a root hole which bears approx. Record S15°E., 6.6 ft. from center of stone mound.

Since this mound and remains of post conforms reasonably well to record measurement to the East and the pattern of the East line of Sec. 28, also since the evidence as found by H. Tambllyn in 1937 looked authentic to him and was used to proportion other corners to the West. (See Morrow County Surveyors Records, Survey No. C-48), it

Description of monument and accessories established to perpetuate the original location of this corner:

Set 2-1/2"x30" aluminum pipe with 2-1/2" aluminum cap, stamped as shown on the **DIAGRAM**, SET 18" in the ground, and raised a mound of stone and earth around the pipe.

From which:
A Tamarack 16" dia. Bears N73°W., 38.4 ft., scribed: T4S R28E S29 BT
A Fir 8" dia. Bears N45°E., 24.5 ft., scribed: T4S R28E S28 BT
A Tamarack 14" dia. Bears S50°E., 42.0 ft., scribed: T4S R28E S33 BT
A Fir 15" dia. Bears S53°W., 19.6 ft., scribed: T4S R28E S32 BT
Measurements to trees taken with a metal tape and magnetic compass, with Declination set off 20 deg. East.
Nailed a brass washer stamped PLS 848 on blaze above BT scribe, Bearing Tree Sign above blaze, and warning sign on back of each tree. Painted a 6" red band at breast ht. around each tree. Set steel fence post with warning Sign, North 4 ft. from the corner.

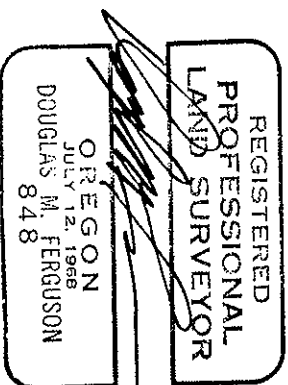

Work by D.M. Ferguson, PLS 848, Mt. Vernon Ore.
On Aug 2, 1984
Witnessed by J. David Brinton, PLS 2065

State of..... OREGON..... I hereby certify that the within instrument was filed in this office
for record on the 10th day of..... September..... 1985
David H. Krumbein..... by..... David M. Ferguson.....
(COUNTY OFFICIAL) (DEPUTY)

RECEIVED BY
Morrow County Surveyor
Date 1-10-86
Rec'd By MJD
No. 788-K
Form R6-7100-57 (9/71) ☆ GPO—798-276