

**CERTIFIED RECORD OF LAND CORNER MONUMENTATION**

Refer to: Plat of Penland 1988 Cadastral Survey  
Section 33, T.49., R.28E., W.M.

W-11

History of original corner establishment:  
No record of previous monumentation.

**DIAGRAM**  
T49 R28E  
C  
N1/16|S33  
C

Description of corner evidence found:  
None.

Description of monument and accessories | established to perpetuate the original location of this corner:

At the corner point I set a 2 1/2" x 30" alum. pipe with a 2 1/2" alum. cap containing a magnet and marked;

Monument is 17" in the ground and surrounded  
by a mound of stone. N1/16|S33  
C  
PLS 1832  
1988

From the corner:

A Ponderosa Pine, 28" dia., N50°W, 43.6 ft.; marked; CN1/16 S33 BT  
A Western Larch, 15" dia., S10°E, 64.8 ft.; marked CN1/16 S33 BT

BTs have blaze and a 6" band painted red, BT tags, "Land Survey Monument" signs and alum. "PLS 1832" washers nailed to the bottom of the blaze. There is a 6' steel fence-post with a "Land Survey Monument" sign within 5' of the corner.

Measured to center of BTs using steel tape and staff compass. Magnetic declination set at 180°E.  
June 30, 1988


RECEIVED BY

MORROW COUNTY SURVEYOR

Date 11/88

Rec'd By LORILEE

No. C 8731K

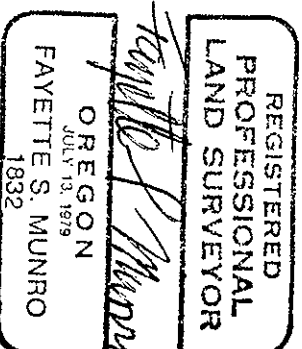

Office of..... County of.....

State of..... I hereby certify that the within instrument was filed in this office

for record on the..... day of....., 19.....

..... by .....  
(COUNTY OFFICIAL) (DEPUTY)