


CERTIFIED RECORD OF LAND CORNER MONUMENTATION

Refer to: Plat of Penland 1988 Cadastral Survey
Section 35, T.4S., R.28E., W.M.

X-11

History of original corner establishment:
No record of previous monumentation.

DIAGRAM
T4S R28E
C 1/4 S33

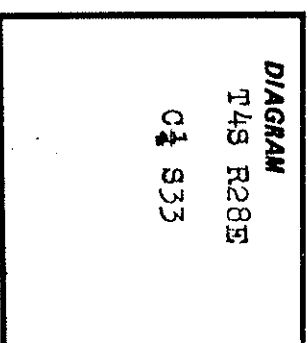

Description of corner evidence found:
None.

Description of monument and accessories established to perpetuate the original location of this corner:

At the corner point, in the edge of a dirt road, I drove a 5/8" x 15" iron rod (rebar) 8" below the surface of the road. Iron rod has a 1 1/8" dia. yellow plastic cap marked: PLS 1832.

From the corner:

A White Fir, 19", N120W, 46.4 ft.; marked: C 1/4 S33 BT
A White Fir, 12", N76 1/4 W, 20.3 ft.; marked: C 1/4 S33 BT
Reference monument; 2 1/2" x 30" alum. pipe with a 2 1/2" alum. cap containing a magnet and marked:
R.M. bears N56 1/4 W, 8.3 ft.

C 1/4 S33
RM
PLS 1832
1988

BTs have blaze and a 6" band painted red, BT tags, "Land Survey Monument" signs and alum. "PLS 1832" washers nailed to the bottom of the blaze. There is a 6' steel fence post with a "Land Survey Monument" sign within 5' of the R.M.

Measured to center of BTs using steel tape and staff compass. Magnetic declination set at 180E.

June 30, 1988


RECEIVED BY

Morrow County Surveyor

Date 11/1988

Rec'd By LOYK

No. G 873K

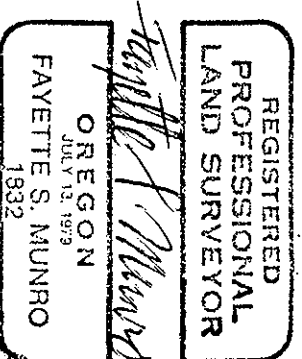

Office of..... County of.....

State of....., I hereby certify that the within instrument was filed in this office for record on the..... day of....., 19.....

(COUNTY OFFICIAL) by..... (DEPUTY)