

CERTIFIED RECORD OF LAND CORNER MONUMENTATION


Refer to: Plat of Penland 1988 Cadastral Survey
Section 33, T.45., R.28E., W.M.

X-13

History of original corner establishment:

Z.F. Moody under G.L.O. contract number 184, dated
Mar. 29, 1873, set a stone 18" x 14" x 5" from
which;

A Pine, 24" dia., S50°W, 55 lks.

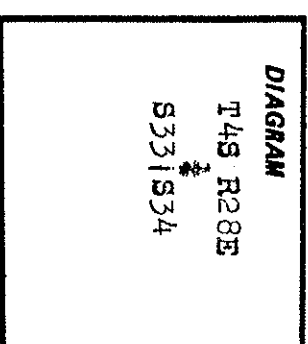

Description of corner evidence found:

I found a broken stone 25" x 9" x 2" marked: 1/4

From the corner:

A Ponderosa Pine snag, 29" dia., S55°W, 30.6 ft.; with scribbling visible.

Description of monument and accessories | established to perpetuate the original location of this corner:

In place of the stone I set a 2 1/2" x 30" alum. pipe with a 2 1/2" alum. cap
containing a magnet and marked:

T4S R28E
1/4
S33|S34
PLS 1832
1988

Monument is 24" in the ground with the original
stone buried alongside.


From the corner:

A Western Larch, 20" dia., S47°W, 61.3 ft.; marked: 1/4 S33 BT
A Ponderosa Pine, 14" dia., S42 1/2°E, 42.3 ft.; marked: 1/4 S34 BT

BTs have blaze and a 6" band painted red, BT tags and "Land Survey
Monument" signs. New BTs have, additionally, alum. "PLS 1832" washers
nailed to the bottom of the blaze. There is a 6' steel fence post with
a "Land Survey Monument" sign within 5' of the corner.

Measured to center of BTs using steel tape and staff compass. Magnetic
declination set at 18°E.

September 16, 1988

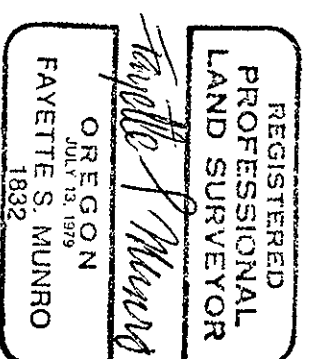

Office of Surveyor County of Morrow
State of Oregon I hereby certify that the within instrument was filed in this office
for record on the day of Nov, 1988

..... by
(COUNTY OFFICIAL) DEPUTY
RECORDED BY

FORM R6-7100-57 (9/71)

Morrow County Surveyor
Date _____
Filed _____
No. E8731