

CERTIFIED RECORD OF LAND CORNER MONUMENTATION

INDEX No. X-21

X-21

History of original corner establishment:

Corner originally established in 1884, by Frank W. Campbell, under General Land Office Contract No. 507. Surveyor General's Notes State: Set a basalt stone, 15x10x10 ins., 10 ins. in the ground, for 1/4 sec. cor., marked 1/4 on W face.

from which A fir 24 ins. in diam. bears N11°E., 173 lks. dist. marked, 1/4 S BT

A pine 12 ins. in diam. bears N73°W., 162 lks. dist. marked, 1/4 S BT

DIAGRAM	
TAS R28E	
1/4	
1	
535.536	
1	
1984	
PLS 848	

Description of corner evidence found:

Found 15"x10"x8" stone, loose, alongside a hole where stone has been removed, (stone fits inside hole), No marks are apparently visible on the stone.

Found a Fir 34" dia., live, with blaze healed over bears N10°45'E., 115.3 ft. from the hole where the stone was set to the face of the blaze. (Record N11°E., 114.2 ft.)

Found a Pine 16" dia., dead and down, bears N75°21'W., 110.0 ft. from the hole where the stone was set to an estimated position where the tree blaze stood when the tree was alive. (Record N73°W., 106.9 ft.)

(measurements made with total station electronic equipment) Accepted the hole where the stone was set as the 1/4 Cor.

Description of monument and accessories | established to perpetuate the original location of this corner:

Set 2-1/2"x30" aluminum pipe with 2-1/2" aluminum cap, stamped as shown on the **DIAGRAM**, SET 20" in the ground, set original stone south alongside pipe and raised a mound of stone & earth around the pipe.


From which

A Fir 10" dia., Bears, N23°W., 77.7 ft., scribed: 1/4 S35 BT

A Fir 25" dia., Bears, N5°E., 92.3 ft., scribed: 1/4 S36 BT

Measurements to trees taken with a metal tape and magnetic compass, with Declination set off 20 deg. East.

Nailed a brass washer stamped PLS 848 on blaze above BT scribe, Bearing tree sign above blaze, and warning sign on back of each tree. Painted a 6" red band at breast ht. around each tree. Set steel fence post with warning sign, alongside corner monument.

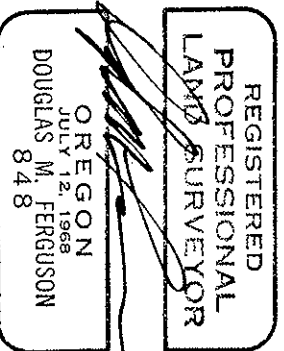

Work by D.M. Ferguson, PLS 848, Mt. Vernon Ore
On July 23, 1984
Witnessed by J. David Brinton, PLS 2065

Office of Sam Neyer County of WAGYON
State of Oregon I hereby certify that the within instrument was filed in this office
for record on the 10th day of September, 1985
by David H. Krumbein David Raymond
(COUNTY OFFICIAL) (DEPUTY)

Form R6-7100-57 (9/71)

RECEIVED BY

1-10-86
MUD
753-K