

CERTIFIED RECORD OF LAND CORNER MONUMENTATION

X-25

INDEX NO. X-25

DIAGRAM (cap)
(TAS R28E)
1/45361
1938
GLD

History of original corner establishment:
 Corner originally established in 1881, by Edward W. Sanderson, under General Land Office Contract No. 417, Surveyor General's Notes State; Set a basalt stone 15x8x6 ins., 10 ins. in ground for 1/4 Sec. Cor., marked 1/4 on W fc. From which A Black Pine 9 in dia. bears N80°E., 55 lks. A Fir 8 in. dia. bears N60°W., 66 lks. dist. mkd. 1/4 S BT In 1938 Leonard Carter, Cadastral Engineer for the "General Land Office" performed a Dependant Resurvey. Those Notes State: The 1/4 sec. 36 only, which is an unmarked sandstone, 16x10x8 ins., firmly set. At point for corner, set an iron post, 3 ft. long, 1 in. diam., 27 ins. in the ground, with the original stone deposited at the base, for 1/4 sec. cor. of sec. 36 only, with brass cap mkd. (see **DIAGRAM**) From which (Carter fd. 2 unrecorded BTs) A white fir 10 ins diam., bears S68°W., 68 lks. dist. mkd. 1/4 S36 BT (New E. A yellow pine, 24 ins. diam bears N59°W., 24 lks. dist. mkd. 1/4 S36 BT (New E. Raised a mound of stone 2-1/2x2 ft. West alongside of cor.

Description of corner evidence found:

Found 2-1/2" brass cap monument stamped as shown on the **DIAGRAM**, on a 1" iron pipe, set with 8" above the ground, with a mound of stone alongside pipe.


Found bearing trees as scribed in 1938, by Carter as described in those notes, one standing at record measurement and one down at approx. record measurement. Did not find the original bearing trees as taken by Sanderson in 1881, or the unrecorded bearing trees as found by Carter in 1938.

Description of monument and accessories | established to perpetuate the original location of this corner:

Maintained Corner by placing a ring of stone around the brass cap monument and setting steel fence posts with warning & boundary signs South and East, 4 ft. from the corner.

Maintained Accessories by painting a 6" red band around the existing bearing trees as taken by Carter in 1938. The proper compliment of bearing tree and warning signs are on the said existing trees.

Scribed new Bearing Trees as Follows:
 A Fir 12" dia. Bears, N56°W., 29.0 ft., scribed 1/4 S36 BT.
 A Fir 9" dia. Bears, West, 16.5 ft., scribed 1/4 S36 BT.
 Measurements to trees taken with a metal tape and magnetic compass, with Declination set off 20 deg. East.
 Nailed a brass washer stamped PLS 848 on blaze above BT scribe, Bearing Tree Sign above blaze, and warning sign on back of each new tree. Painted a 6" red band at breast ht. around each new tree.

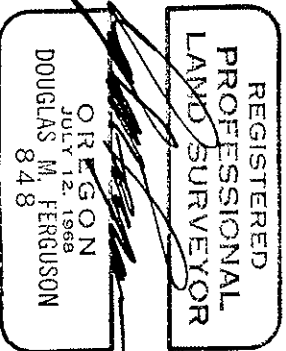

Work by D.M. Ferguson, PLS 848, Mt. Vernon Ore.
 On July 24, 1984
 Witnessed by J. David Brinton, PLS 2065

 State of OREGON I hereby certify that the within instrument was filed in this office
 for record on the 10th day of September, 1988
David H. Krumbein by Brent Reynolds
 (COUNTY OFFICIAL) (DEPUTY)