

CERTIFIED RECORD OF LAND CORNER MONUMENTATION

Refer to: Plat of Penland 1988 Cadastral Survey
Section 33, T.45., R.28E., W.M.

X - 9 1/2

History of original corner establishment:
No record of previous monumentation.

DIAGRAM
T49 R28E
S33
C-W-M
1/64

Description of corner evidence found:
None.

Description of monument and accessories I established to perpetuate the original location of this corner:

At the corner point I set a 2 1/2" x 30" alum. pipe with a 2 1/2" alum. cap containing a magnet and marked;

Monument is 16" in the ground and surrounded by a mound of stone.
S33
C-W-M
1/64
PLS 1832
1988


From the corner;

A Ponderosa Pine, 20" dia., N75°W, 32.4 ft.; marked; C W W 1/64 S33 BT
A Ponderosa Pine, 28" dia., S39 3/4°W, 89.2 ft.; marked; C W W 1/64 S33 BT
BTs have blaze and a 6" band painted red, BT tags, "Land Survey Monument" signs and alum. "PLS 1832" washers nailed to the bottom of the blaze.
There is a 6' steel fence-post with a "Land Survey Monument" sign within 5' of the corner.

Measured to center of BTs using steel tape and staff compass. Magnetic declination set at 16 1/2° E.
June 22, 1988

RECEIVED BY
Morrow County Surveyor

Date 11/1988
Rec'd By [Signature]
No. C 273K

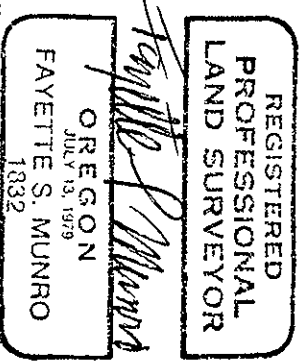

Office of..... County of.....
State of..... I hereby certify that the within instrument was filed in this office
for record on the..... day of....., 19.....
..... (COUNTY OFFICIAL) by (DEPUTY)