


**CERTIFIED RECORD OF LAND CORNER MONUMENTATION**

Refer to: Plat of Penland 1988 Cadastral Survey  
Section 33, T.4S., R.28E., W.M.

X-9

**History of original corner establishment:**

Z.F. Moody under G.L.O. contract number 184, dated  
Mar. 29, 1873, set a post in an earth mound.

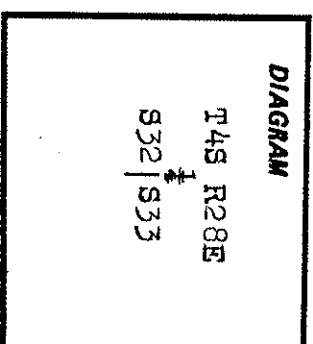

**Description of corner evidence found:**  
None.

**Description of monument and accessories I established to perpetuate the original location of this corner:**

At the corner point established by proportionate measurement, I set a  
2 1/2" x 30" alum. pipe with a 2 1/2" alum. cap containing a magnet and marked:

Monument is 24" in the ground.

T4S R28E

S32 | S33  
PLS 1832  
1988

From the corner:

A Western Larch, 16" dia., N70 1/2° E, 31.8 ft.;

marked: 1/4 S33 BT

A Western Larch, 13" dia., N28° W, 62.6 ft.; marked: 1/4 S32 BT

BTs have blaze and a 6" band painted red, BT tags, "Land Survey Monument"  
signs and alum. "PLS 1832" washers nailed to the bottom of the blaze.  
There is a 6' steel fence-post with a "Land Survey Monument" sign within  
5' of the corner.

Measured to center of BTs using steel tape and staff compass. Magnetic  
declination set at 190E.

June 14, 1988


RECEIVED BY

Morrow County Surveyor

Date 11/18/88

Rec'd By LOK

No. 98731

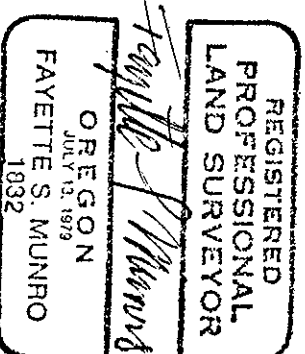

Office of..... County of.....

State of..... I hereby certify that the within instrument was filed in this office  
for record on the..... day of....., 19.....

..... by .....  
(COUNTY OFFICIAL) (DEPUTY)