


CERTIFIED RECORD OF LAND CORNER MONUMENTATION

INDEX No. Y-23

History of original corner establishment:

Corner not previously established.

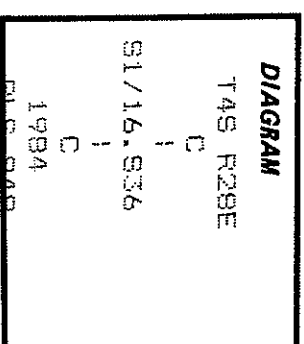

Description of corner evidence found:

Corner not previously established.

Description of monument and accessories | established to perpetuate the original location of this corner:

Set 2-1/2"x30" aluminum pipe with 2-1/2" aluminum cap, stamped as shown on the DIAGRAM, SET 28" in the ground.


From which:

A Fir 10" dia. Bears S58°E., 13.7 ft., scribed: C-S 1/16 S36 BT

A Fir 9" dia. Bears S45°W., 29.5 ft., scribed: C-S 1/16 S36 BT

Measurements to trees taken with a metal tape and magnetic compass, with Declination set off 20 deg. East.

Nailed a brass washer stamped PLS 848 on blaze above BT scribe, Bearing tree sign above blaze, and warning sign on back of each tree. Painted a 6" red band at breast ht. around each tree. Set steel fence posts with warning & Boundary Signs, North & East, 4 ft. from the corner.

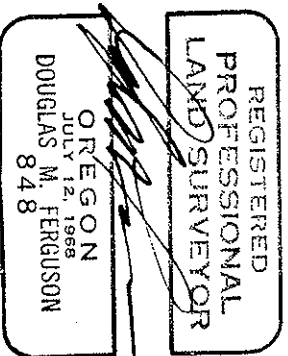

Work by D.M. Ferguson, PLS 848, Mt. Vernon Ore.
On July 24, 1984
Witnessed by J. David Brinton, PLS 2065

Office of... Susney J. O'S County of... WASCO

State of... Oregon, I hereby certify that the within instrument was filed in this office for record on the... 10th day of... September, 1985

... David H. Krumbein by... David Raymond

(COUNTY OFFICIAL) (DEPUTY)

Form R6-7100-57 (9/71)

RECEIVED 27

* GPO—796-276

RECEIVED 27

1-16-86

MID

755-K