


CERTIFIED RECORD OF LAND CORNER MONUMENTATION

Refer to: Plat of Penland 1988 Cadastral Survey
Section 33, T.49., R.28E., W.M.

History of original corner establishment:
No record of previous monumentation.

Y-9 1/2

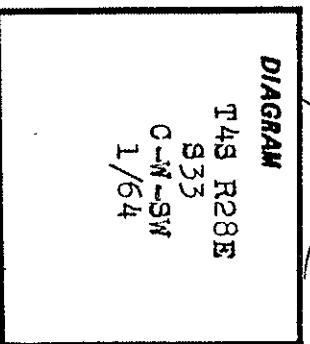

Description of corner evidence found:
None.

Description of monument and accessories established to perpetuate the original location of this corner:

At the corner point I set a 2 1/2" x 30" alum. pipe with a 2 1/2" alum. cap containing a magnet and marked:

Monument is 22" in the ground and surrounded by a mound of stone.

S33
C-W-SW
1/64
PLS 1832
1988

From the corner:

A Ponderosa Pine, 31" dia., S54°0E, 67.8 ft.; marked: C W SW 1/64 S33 BT
A Ponderosa Pine, 19" dia., N70°0E, 86.6 ft.; marked: C W SW 1/64 S33 BT

BTs have blaze and a 6" band painted red, BT tags, "Land Survey Monument" signs and alum. "PLS 1832" washers nailed to the bottom of the blaze. There is a 6' steel fence post with a "Land Survey Monument" sign within 5' of the corner.

Measured to center of BTs using steel tape and staff compass. Magnetic declination set at 18 1/2°E.

June 22, 1988.


RECEIVED BY

Morrow County Surveyor

Date 11/28

Rec'd By [Signature]

No. C 8731K

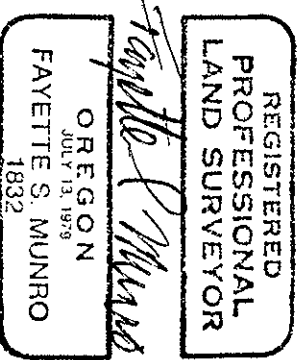

Office of..... County of.....

State of..... I hereby certify that the within instrument was filed in this office

for record on the..... day of....., 19.....

(COUNTY OFFICIAL) by (DEPUTY)