

History of original corner establishment:

Z.F. Moody under G.L.O. contract no. 184, dated Mar. 29, 1873, set a post in an earth mound from which:
A Fir, 12" dia., S30°E, 20 lks.
A Fir, 6" dia., N10°E, 3 lks.
E.W. Sanderson under G.L.O. contract no. 417, dated Aug. 24, 1881, found the post from which:
A Fir, 10" dia., S20°E, 22 lks..
A Fir, 9" dia., N15°E, 10 lks.

Leonard Carter, Public Land Surveyor, under G.L.O. special instructions, Group No. 228, dated Mar. 23, 1938, found a sandstone 16" x 10" x 5" marked $\frac{1}{4}$ C S on N. face. (I find no record of this stone.)
(Continued on Page 2 of 2.)


Description of corner evidence found:

I found a 1" Iron pipe with a 2 $\frac{1}{2}$ " brass cap marked:
From the corner: # S33
1938

A White Fir, 22" dia., N47°E, 56.0 ft.; with a healed blaze.
A White Fir snag, 15" dia., N14 $\frac{1}{2}$ °W, 68.0 ft.; with a healed blaze.

Description of monument and accessories | established to perpetuate the original location of this corner:

I marked a new BT:
A White Fir, 27" dia., N69 $\frac{1}{2}$ °W, 81.0 ft.; marked: $\frac{1}{4}$ S33 BT
BTs have blaze and a 6" band painted red, BT tags and "Land Survey Monument" signs. New BT has, additionally, an alum. "PLS 1832" washer nailed to the bottom of the blaze. There is a 6' steel fence post with a "Land Survey Monument" sign within 5' of the corner.
Measured to center of BTs using steel tape and staff compass. Magnetic declination set at 180E.
September 16, 1988

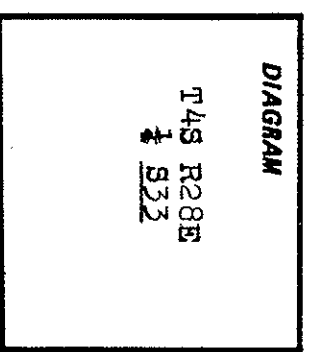

RECEIVED BY
Date 11/98
Rec'd By DKK
No. C873K
(1 of 2)

REGISTERED
PROFESSIONAL
LAND SURVEYOR
Fayettes S. Munro
OREGON
JULY 13, 1919
FAYETTES S. MUNRO
1892

Office of..... County of.....
State of..... I hereby certify that the within instrument was filed in this office
for record on the..... day of....., 19.....
..... by
(COUNTY OFFICIAL) (DEPUTY)