

History of original corner establishment:


(Continued from Page 1 of 2.)
Corner replaced the stone with a 1" x 3' iron post
with a brass cap marked;
From the corner:

1 933
1938

A White Fir stump, 14" dia., S200E, 22 lks. (Old BT)


A White Fir, 15" ; N47°E, 86 lks.

A White Fir, 9" dia., N13½°W, 103 lks.

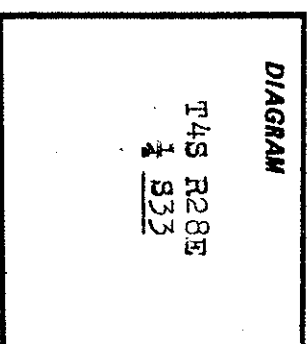

Description of corner evidence found:

Description of monument and accessories | established to perpetuate the
original location of this corner:

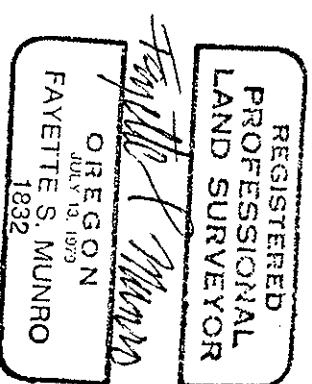

Office of..... County of.....

State of....., I hereby certify that the within instrument was filed in this office
for record on the..... day of....., 19.....

..... RECEIVED BY (DEPUTY)

(COUNTY OFFICIAL)

Morrow County Surveyor

Form R6-7100-57 (9/71)

Date 11/88

Rec'd By DHK

No. 0873K

(2 of 2)