


CERTIFIED RECORD OF LAND CORNER MONUMENTATION

INDEX No. Z-24

Z-24

History of original corner establishment:

Corner not previously established.

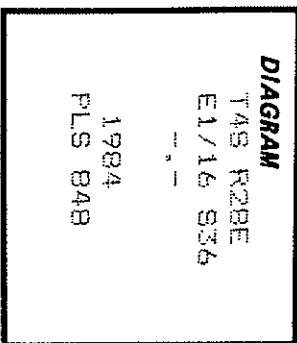

Description of corner evidence found:

Corner not previously established.

Description of monument and accessories | established to perpetuate the original location of this corner:

Set 2-1/2"x30" aluminum pipe with 2-1/2" aluminum cap, stamped as shown on the **DIAGRAM**, SET 26" in the ground.


From which.

A Lodgepole Pine 16" dia. Bears, N80°W., 43.8 ft., scribed: E1/16 S36 BT

A Lodgepole Pine 5" dia. Bears, N56-1/2°E., 26.3 fr., scribed: 1/16 BT

Measurements to trees taken with a metal tape and magnetic compass, with Declination set off 20 deg. East.

Nailed a brass washer stamped PLS 848 on blaze above BT scribe, Bearing Tree sign above blaze, and warning sign on back of each tree. Painted a 6" red band at breast ht. around each tree. Set steel fence posts with warning & Boundary Signs, North & East 5 ft. from the corner.

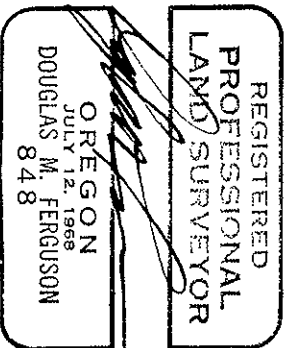

Work by D.M. Ferguson, PLS 848, Mt. Vernon Oreg.  
On July 23, 1984  
Witnessed by J. David Brinton, PLS 2065


State of... OREGON ..... I hereby certify that the within instrument was filed in this office  
for record on the... 12th ... day of... September ..... 1983

... David H. Krimbein ... by... Brent Reynolds ...  
(COUNTY OFFICIAL) (DEPUTY)

Form R6-7100-57 (9/71)

1-10-86  
MID  
757-K