

INDEX No. Z-25

T45

<b>DIAGRAMS</b>	
R28E R29E	
S361S31	
-----	
T5S R28E S1	
1938	
GLD	


History of original corner establishment in 1881, by Carter of originally established in 1881, by Edward W. Sanderson, under General Land Office Contract No. 417, Surveyor General's Notes State: Set a basalt stone 15x12x6 ins. 10 ins in ground for cor to twp. 4s Rgs. 28 & 29E., marked with 6 notches on E.N. & W. edges. from which: A tamarack 10 in. dia. bears N42°E., 25 1ks., A tamarack 6 in. dia. bears N45°W., 23 1ks., In 1938 Leonard Carter, Cadastral Engineer for the "General Land Office" performed a Dependent Resurvey, Those Notes State: The Cor. of T4S R28&29E., which is a basalt stone, 14x12x6 ins., firmly set, mkd. with 6 grooves on E&W faces; no accessories. At point for corner set an iron post, 3 ft. long 3 in. diam. 27 ins. in the ground, with brass cap mkd. (see DIAGRAM); from which: of T4S R28 & 29E., with brass cap mkd. (see DIAGRAM); from which: A Douglas fir, 33 ins. diam.; bears N50°E., 144 1ks; mkd. T4S R29E S31 BT A white fir, 14 ins. diam.; bears N29°W., 99 1ks; mkd. T4S R28E S36 BT.

Description of corner evidence found:  
 Found 3" brass cap monument, on iron pipe, stamped as shown on the **DIAGRAM**, set with 8" above the ground.

Found Bearing Trees as taken and described by Carter in 1938, dead and standing, at record measurement. Did not find the original bearing trees as established by Sanderson, in 1881.

**Description of monument and accessories | established to perpetuate the original location of this corner:**

Maintained Corner by setting a steel fence post with warning and boundary signs, West 2 ft. and North 4 ft. from the corner. Maintained Accessories by painting a 6 " red band around each existing dead tree, and scribing New Bearing Trees, as follows:  
 A Fir 16" dia. Bears N32°W., 23.5 ft., scribed: T4S R28E S36 BT  
 A Fir 10" dia. Bears N85°E., 19.5 ft., scribed: T4S R29E S31 BT  
 Measurements to trees taken with a metal tape and magnetic compass, with Declination set off 20 deg. East.  
 Nailed a brass washer stamped PLS 848 on blaze above BT scribe, Bearing Tree Sign above blaze, and warning sign on back of each tree. Painted a 6" red band at breast ht. around each tree.

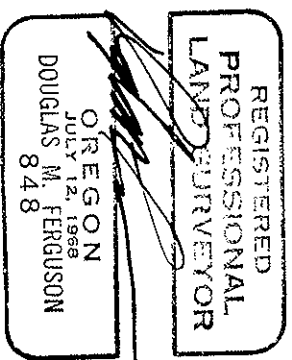

Work by D.M. Ferguson, PLS 848, Mt. Vernon Ore.  
 On July 23, 1984  
 Witnessed by J. David Brinton, PLS 2065

Office of SUNNEY County of WASCO  
 State of Oregon I hereby certify that the within instrument was filed in this office  
 for record on the 18 day of September, 1985  
David H. Krumbein by David Reynolds  
 (COUNTY OFFICIAL) (DEPUTY)

1-10 86  
 MLD  
 958-K