

INDEX No. 2-5

History of original corner establishment:

Corner originally established in 1873, by Zenas F. Moody, under General Land Office Contract No. 104. Surveyor General's Notes State: Set stone 20x12x8 in stone mound for cor to sec. 31 32-5-6.

In 1938 Leonard Carter, Cadastral Engineer for the "General Land Office" performed a Dependent Resurvey; Those Notes State: Proportional measurement; Set an iron post, 3 ft. long, 2 in. diam.; 12 ins. in the ground to bed rock, and in a mound of stone to top, for the cor. of secs. 31 & 32 only; with a brass cap, wkd. (see below in evidence found.)

A yellow pine, 10 ins. diam.; bears N28°E.; 47 lks wkd. T49 R28E S32 BT  
A yellow pine, 8 ins. diam.; bears N38°W.; 54 lks wkd. T49 R28E S31 BT  
Description of corner evidence found:


Found 2"x3/8" iron pipe with 2-1/2" brass cap stamped as shown pt. 149 R28E S31S32  
Lying loose alongside a mound of stone. 159 R29E S6 1939

Found a pine 20" dia.; live in good condition; with blaze healed over bears Record N28°E.; 31.0 ft.; from the center of the stone mound. Found a pine 14" dia.; live in good condition; with blaze healed over bears Record N38°W.; 35.4 ft. from the center of the stone mound. Found the corner to secs. 6/8 on line between this corner and the South 1/4 corner of this section 32 at record 299.32 ft. Easterly from this corner. Accepted the center of the stone mound as the Sec. Cor.  
Description of monument and accessories | established to perpetuate the original location of this corner:

Set 2-1/2"x3/8" aluminum pipe with 2-1/2" aluminum cap; stamped as shown on the DIAGRAM, SET 12" in the ground; and raised a mound of stone & earth around the pipe. Placed 1938 monument on stone mound.

From which:  
Re scribed the original bearing tree; scribed: T49 R28E S32 BT  
Re scribed the original bearing tree; scribed: T49 R28E S31 BT  
Measurements to trees taken with a metal tape and magnetic compass; with Declination set off 20 deg. East.  
Nailed a brass washer stamped PLS 848 on blaze above BT scribe; Bearing Tree Sign above blaze; and warning sign on back of each tree. Painted a 6" red band at breast ht. around each tree. Set steel fence post with warning sign, North 2.4 ft. from the corner.

RECEIVED BY

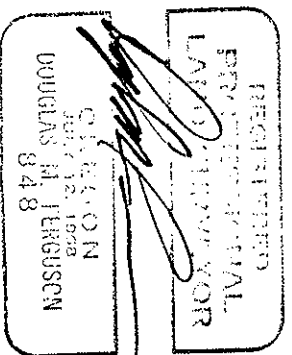

Morrow County Surveyor  
Date 1-10-86  
Incd. MLD  
No. 734-K

Work by D.M. Ferguson, PLS 848, Mt. Vernon Ore.  
On Aug. 3, 1984  
Witnessed by J. David Brinton, PLS 2065

David H. Krambein by Brent Reynolds  
(COUNTY OFFICIAL) (DEPUTY)