

CERTIFIED RECORD OF LAND CORNER MONUMENTATION

INDEX No. A-6  
History of original corner establishment:

Corner not previously established.

<b>DIAGRAM</b>	
T4S	R28E
-	-
W1/16	SS
T5S	
1984	
PLS	848


Description of corner evidence found:

Corner not previously established.

Description of monument and accessories | established to perpetuate the original location of this corner:

Set 2-1/2"x30" aluminum pipe with 2-1/2" aluminum cap, stamped as shown on the DIAGRAM, SET 15" in the ground, and raised a mound of stone & earth around the pipe.

From which:  
A Fir 6" dia. Bears, S65°W., 10.6 ft. scribed: W1/16 SS BT  
A Fir 14" dia. Bears, S63°E., 6.3 ft. scribed: W1/16 SS BT  
Measurements to trees taken with a metal tape and magnetic compass, with Declination set off 20 deg. East.  
Nailed a brass washer stamped PLS 848 on blaze above BT scribe, Bearing Tree Sign above blaze, and warning sign on back of each tree. Painted a 6" red band at breast ht. around each tree. Set steel fence posts with warning & Boundary Signs, South & East 5 ft. from the corner.

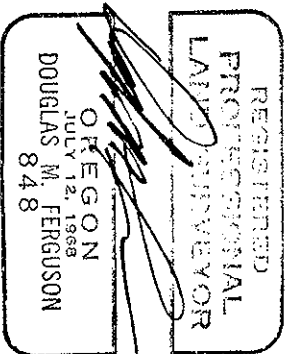

RECEIVED BY  
Marilyn Donahy Surveyor  
1-10-86  
MUD  
743-K

Work by D.M. Ferguson, PLS 848, Mt. Vernon Ore.  
On Aug. 8, 1984

Office of.....SURVEYOR.....<sup>4</sup> County of.....WASCO.....  
 State of.....OREGON..... I hereby certify that the within instrument was filed in this office  
 for record on the.....10<sup>th</sup> day of.....SEPTEMBER..... 1985  
 by.....David H Krumbein.....<sup>(COUNTY OFFICIAL)</sup> by.....Bruce Reynolds.....<sup>(DEPUTY)</sup>