

INDEX No. Z-7

Z-7

History of original corner establishment:  
Corner originally established in 1873, by  
Zenas F. Moody, under General Land Office  
Contract No. 184. Surveyor General's Notes  
State: Set stone 14x12x8 in stone mound for  
1/4 sec. cor.

DIAGRAM  
T4S R28E  
1/4 S32  
1984  
PLS 848

In 1938 Leonard Carter, Cadastral Engineer for the "General Land Office,"  
performed a Dependent Resurvey, Those Notes State: Proportionate measure  
set an iron post, 3 ft. long, 1 ins. diam., 16 ins. in the ground, to  
bedrock, and in a mound of stone to top, for 1/4 sec. cor. or sec. 32  
only, with brass cap mtd. (see below, Evidence Found) From which:  
A yellow pine, 20 ins. diam., bears N62°E., 35 lks. mtd. 1/4 S32 BT  
A yellow pine, 20 ins. diam., bears N24°W., 67 lks. mtd. 1/4 S32 BT


Description of corner evidence found:

Found 2"x3/8" iron pipe with 2-1/2" 1/4 S32  
brass cap stamped as shown pt. \_\_\_\_\_  
lying loose alongside a primitive 1938  
road.  
Found 26" pine, live in good condition with scribing  
visible, bears Record from a point.  
Found a Rotten Pine stump with detached scribing, reads  
1/4 S32 BT, bears Record from a point.  
Accepted said point as established from the bearing  
trees as the 1/4 corner position.

Description of monument and accessories established to perpetuate the  
original location of this corner:

Set 2-1/2"x3/8" aluminum pipe with 2-1/2" aluminum cap, stamped as shown  
on the DIAGRAM, SET 12" in the ground, and raised a mound of stone and  
earth around pipe. Placed original pipe on stone mound.  
From which:  
New Bearing Tree, A Fir, 21" dia. Bears, N17°W., 52.3 ft., scribed: 1/4 S32 E  
Re-scribed original Bearing tree, Bears, N62°E., 23.1 ft., scribed: 1/4 S32 E  
Measurements to trees taken with a metal tape and magnetic compass,  
with Declination set off 20 deg. East.  
Nailed a brass washer stamped PLS 848 on blaze above BT scribe, Bearing  
Tree Sign above blaze, and warning sign on back of each tree. Painted  
2 6" red band at breast ht. around each tree. Set steel fence post with  
warning sign, West 5 ft. from the corner.

RECEIVED BY

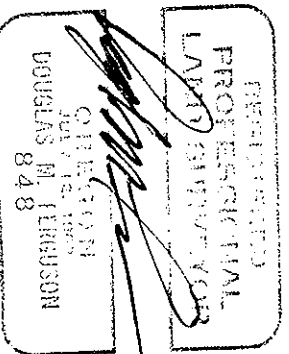

Received by  
D.M. Ferguson  
No. 736-K

Work by D.M. Ferguson, PLS 848, Mt. Vernon Ore.  
On Aug. 5, 1984  
Witnessed by J. David Drinton, PLS 2065

State of... OREGON ..... I hereby certify that the within instrument was filed in this office  
for record on the 10<sup>th</sup> day of September, 1985  
David H. Krumbein by Brent Raymond  
(COUNTY OFFICIAL) (DEPUTY)