

CERTIFIED RECORD OF LAND CORNER MONUMENTATION

C - 21  
DIAGRAM

T4S R29E
1/4
S2 S1
PLS 1636
2000

History of original corner establishment:

The original corner was established by Edward W. Sanderson on August 18, 1882, under GLO contract No. 417, as follows:

Set a basalt stone, 18" x 8" x 6", 12" into the ground for the 1/4 section corner marked 1/4 on the north face, from which:

- A 8" pine bears West, 33 links (21.78 feet).
- A 8" fir bears S50°E, 64 links (42.24 feet).

Original corner evidence recovered:

Found the original corner stone solidly set in a mound of stones. The stone is basalt, is 18" x 10" x 7" and is marked "1/4" on the north face, from which:

- A live 16" Ponderosa Pine with a healed blaze bears West, 21.1 feet. I nail a "Bearing Tree" sign above the blaze.
- A broken 15" Douglas-fir stump, previously opened to visible scribes, bears S53° 30'E, 42.6 feet.

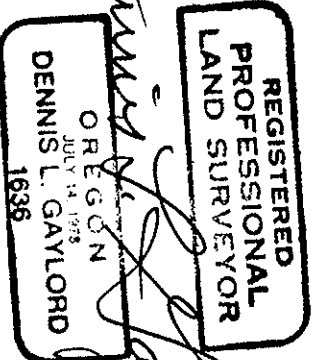
Monument and accessories established to perpetuate the original position of this corner:

In place of the original corner stone, I set a 1" x 30" galvanized iron pipe 18" into the ground. A 2 1/2" brass cap attached to the pipe is marked as shown in the diagram above. I bury the corner stone along the west side of the pipe and build a mound of stones around the pipe, from which:

- A 15" Ponderosa Pine, scribed "1/4 S1 BT" on double blazes, bears N29°E, 25.2 feet.
- A 8" Douglas-fir, scribed "1/4 S1 BT" on double blazes, bears S77°E, 57.0 feet.
- A 7" Ponderosa Pine, scribed "1/4 S2 BT" on double blazes, bears S0° 30'W, 47.3 feet.

The new bearing trees each have a 3/4" brass washer, marked "PLS 1636", nailed flush to the scribed "B".

I hereby certify the above corner point was perpetuated as hereon described on July 28, 2000. Magnetic declination set in compass: 18°E.

  
*Dennis L. Gaylord*

Renews June 30, 2001.

Recorded at the office of County Surveyor, County of Morrow, State of Oregon, on: