

CERTIFIED RECORD OF LAND CORNER MONUMENTATION

J-19

History of original corner establishment:

Corner established in 1882 by Edward W. Sanderson, under General Land Office Contract No. 417. Surveyor General's records state:  
 Set sandstone 18x6x6 ins. 12 ins. in ground for 1/4 Sec. Cor. marked 1/4 on N face.  
 From which:  
 A pine 30 ins. dia. bears N65°E, 27 lks. dist. marked 1/4 S 8T.  
 A pine 24 ins. dia. bears S45°E, 46 lks. dist. marked 1/4 S 8T.

DIAGRAM	
T45	R29E
1/4	S 11
	S 14
	1981
	PLS 848

Description of corner evidence found:

Found 18"x6"x6" sandstone set loosley in a mound of stone. No bearing trees fit record calls, however 2 trees with grown-over blazes face the stone. Apparently the trees were miscalled in the original notes.  
 Accepted sandstone as the 1/4 corner position.

Description of monument and accessories | established to perpetuate the original location of this corner:


Set 3"x30" galv. iron pipe with 3" brass cap stamped as shown on the diagram, set 16 inches in the ground. Set original stone North alongside pipe and placed a ring of stone around pipe.  
 From which:  
 A fir 8 in. dia. bears N20°W, 24.0 ft. scribed 1/4 S 11 8T.  
 A fir 15 in. dia. bears South 42.3 ft. scribed 1/4 S 14 8T.  
 Set a steel post with warning sign 5 ft. West from corner.  
 Nailed bearing tree signs and brass washers stamped PLS 848 to each tree.  
 Painted red band around each tree.

I hereby certify that the above corner monument was reestablished as herein described, on 9/3/81.

Witnesses

Mike Woodward

Jeff Smith

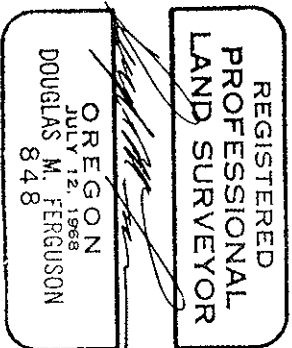

Office of Co. Surveyor ..... County of Umatilla  
 State of Oregon .....  
 I hereby certify that the within instrument was filed in this office for record on the 17th day of September, 1981  
Douglas M. Ferguson by Betty Skelley  
 (COUNTY OFFICIAL) (DEPUTY)

Form R6-7100-57 (9/71)

RECEIVED BY  
 No. 455-K  
 Ref. AVNG. DC C 447K