


J-21

History of original corner establishment:

Corner established in 1882 by Edward W. Sanderson under General Land Office Contract No. 417. Surveyor General's records state:

Set basalt stone 21x8x6 ins. 14 ins in ground. for corner to Secs. 11, 12, 13 and 14, marked with 4 notches on S & 1 notch on E edges.

From which  
 A pine 10 in. dia. bears N22°E, 80 lks. dist. marked T45 R29E S 12 BT.  
 A pine 18 in. dia. bears N55°W, 14 lks. dist. marked T45 R29E S 11 BT.  
 A pine 30 in. dia. bears 576°W, 54 lks. dist. marked T45 R29E S 14 BT.  
 A pine 36 ins dia. bears 545°E, 28 lks. dist marked T45 R29E S 13 BT,

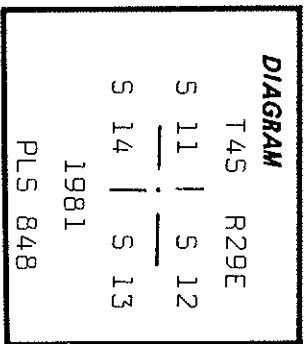

Description of corner evidence found:

Found 22"x10"x7" stone set 12" in the ground with 4 notches visible on the South edge.

From which:

A root hde with rotten remains of pine and blaze with scribing reading T45 R29E S 12 BT, bears N22°E, 53 ft.  
 A pine 40" dia. live, in good condition, scribing reads 9E S 14, bears 576°W, 37 ft.  
 A burnt pine snag bears 545°E, 17 ft. No marks. Accepted center of stone as Sec. Cor. position.

Description of monument and accessories | established to perpetuate the original location of this corner:

Set 3"x30" galv. iron pipe with 3" brass cap stamped as shown on the diagram, set 25 inches in the ground and set the original stone North alongside pipe.

From which:


A fir 9 in. dia. bears N32°W, 10.1 ft. scribed T45 R29E S 11 BT.  
 A fir 13 in. dia. bears N53°E, 28.0 ft. scribed T45 R29E S 12 BT.  
 A fir 8 in. dia. bears 555°E, 5.7 ft. scribed T45 R29E S 13 BT.  
 A fir 9 in. dia. bears 542°W, 8.7 ft. scribed T45 R29E S 14 BT.  
 Set a steel post and warning sign 4 ft. North from corner.  
 Nailed bearing tree signs and brass washers stamped PLS 848 to each tree.  
 Painted red band around each tree.

I hereby certify that the above corner monument was reestablished as herein described, on 9/3/81.

Witnesses:

Dave Herburger

Mike Woodward

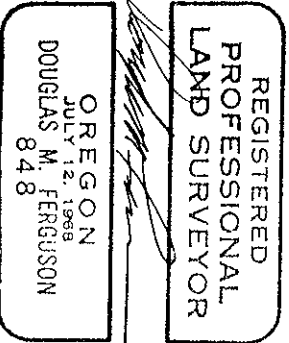

Office of.....CO. SURVEYOR.....County of.....Umatilla  
 Oregon.....I hereby certify that the within instrument was filed in this office  
 for record on the 15 day of January 1982  
 David Brown Davis by Betty Shest (DEPUTY)

JANUARY 7, 1982  
 M. H. HUGHES