


J-23

History of original corner establishment:

Corner established in 1882 by Edward W. Sanderson under general Land Office Contract No. 417. Surveyor Generals' records state: Set basalt stone 18x12x6 ins. 12 ins. in ground for 1/4 Sec. Cor., marked 1/4 on N. face. From which
 A pine 10" dia. bears North 31 lks. dist. marked 1/4 S BT.
 A pine 10" dia. bears S65°E 25 lks. dist. marked 1/4 S BT.

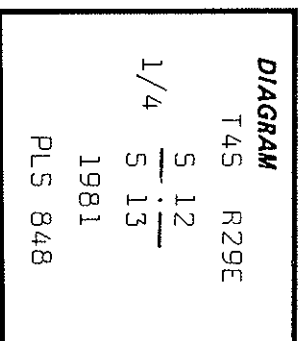

Description of corner evidence found:

Found 18"x12"x6" stone, when set upright, 1/4 is visible on North face.
 From which
 A pine 24 in. dia., live in good condition, bears N2°W, 21 ft. scribing visible 1/4S.
 A pine stump 20 in. dia. bears S65°E, 20 ft. No scribing on stump. Accepted center of stone as 1/4 cor. position.

Description of monument and accessories I established to perpetuate the original location of this corner:


Set 3"x30" galv. iron pipe with 3" brass cap stamped as shown on the diagram, set 22 inches in the ground, placed original stone North alongside pipe.
 From which
 A pine 14 inches dia. bears N43°E, 29.2 ft., scribed 1/4 S 12 BT.
 A pine 9 inches dia. bears S37°W, 38.7 ft., scribed 1/4 S 13 BT.
 Set a steel post with warning sign 5 ft. North from corner.
 Nailed bearing tree signs and brass washers stamped PLS 848 to each tree.
 Painted red band around each tree.

I hereby certify that the above corner monument was reestablished as herein described, on 9/3/81.

Witnesses:

Mike Woodward

Jeff Smith

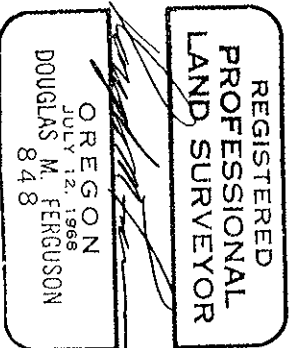

Office of..... Co. Surveyor..... County of..... Umatilla
 State of..... OREGON..... I hereby certify that the within instrument was filed in this office for record on the 7th day of November, 1981
 by Douglas M. Ferguson by Betty Smith
 (COUNTY OFFICIAL) (DEPUTY)

RECEIVED BY
 Morrow County Surveyor
 Date: NOVEMBER 7, 1982
 Read By: Al Hughes
 No. 491-15
 * GPO—798-276