


CERTIFIED RECORD OF LAND CORNER MONUMENTATION

HISTORY OF ORIGINAL CORNER ESTABLISHMENT:
Corner was not set in the original survey.

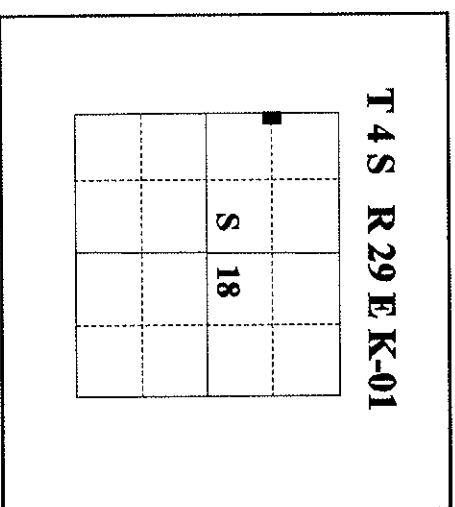

No record of subsequent monumentation found in Morrow County survey records.
DESCRIPTION OF CORNER EVIDENCE FOUND:
Not applicable.

See Map of Survey filed in the office of the Morrow County Surveyor,
dated Aug. 1995.

DESCRIPTION OF MONUMENT AND ACCESSORIES I ESTABLISHED
TO PERPETUATE THE ORIGINAL LOCATION OF THIS CORNER:
At the point mid-way between the NW corner of the section and the west one
quarter corner I set a 5/8" X 30" rebar with 2" aluminum cap marked as shown;
from which:

NEW BEARING TREES:

- A 11" Lodgepole Pine bears N 8°E, 53.07 feet, marked N 1/16 S18 BT
- A 8" Lodgepole Pine bears S 41°E, 83.86 feet, marked X BT
- Raised small mound of stone.
- Drove steel fence post 14 foot south.


REGISTERED
PROFESSIONAL
LAND SURVEYOR

Gregory T. Blackman

OREGON
JULY 24, 1973

GREGORY T. BLACKMAN
991

Renewed State Examination, 31 1995

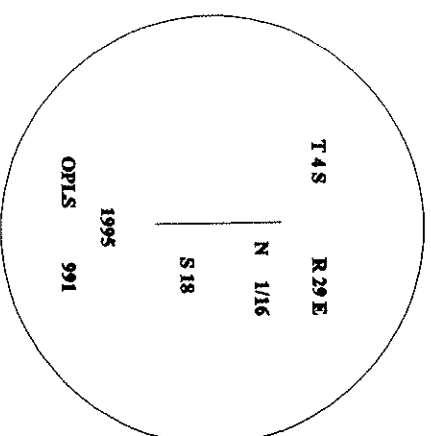

RECEIVED BY
Morrow County Surveyor

Date 9/22/95

Rec'd by SKB

No. _____

I used a steel tape and magnetic compass in
the establishment of the new accessories. I
used 17° East declination, the distances are
to a 50d spike driven in the right side of
the root crown. I attached a brass washer
marked OPLS 644 to the bearing tree blaze.