


CERTIFIED RECORD OF LAND CORNER MONUMENTATION

L-21

History of original corner establishment:

Corner established in 1882 by Edward W. Sanderson, under General Land Office Contract No. 417. Surveyor General's records state:

Set a basalt stone 15x12x6 ins. 10 ins. in ground for 1/4 Sec. Cor. marked 1/4 on W face. From which  
 A pine 15" dia. bears S80°E 50 lks. dist. marked 1/4 S BT.  
 A pine 14" dia. bears N50°W 42 lks. dist. marked 1/4 S BT.

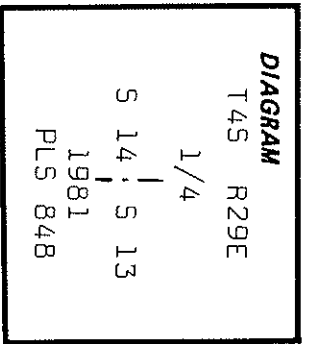

Description of corner evidence found:

Original stone not found.

No evidence of bearing trees found. After making 3 separate searches in the area, no evidence is found. Corner has been destroyed by logging; therefore set corner position by proportion.

Description of monument and accessories | established to perpetuate the original location of this corner:


Set 3"x30" galv. iron pipe with 3" brass cap, stamped as shown on the diagram, set 20 inches in the ground.  
 From which:  
 A pine 12 inches dia. bears N45°E, 35.8 ft. scribed 1/4 S 13 BT.  
 A fir 10 inches dia. bears S38°W, 49.1 ft. scribed 1/4 S 14 BT.  
 Set a steel post with warning sign 3 ft. North from corner.  
 Nailed bearing tree signs and brass washers, stamped PLS 848 to each tree.  
 Painted red band around each tree.

I hereby certify that the above corner monument was reestablished as herein described, on 9/3/81.

Witnesses:

Mike Woodward

Jeff Smith

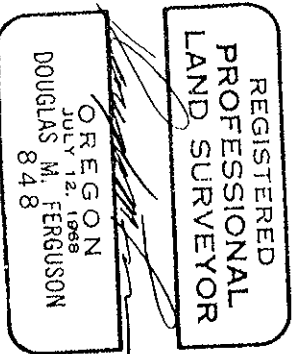

Office of CO. SURVEYOR ..... County of Umatilla .....  
Oregon  
 State of Oregon I hereby certify that the within instrument was filed in this office  
 for record on the 27<sup>th</sup> day of January ..... 1981  
David Norman Dehn by Billy Starb  
 (COUNTY OFFICIAL) (DEPUTY)

Form R6-7100-57 (9/71)

**RECEIVED BY**  
Morrow County Surveyor

Date January 7, 1981  
 Rec'd By M. Higgins  
 No. 45027-K  
 Ref. DWG. No. C-447-K