

CERTIFIED RECORD OF LAND CORNER MONUMENTATION

History of original corner establishment:

Corner originally established by Edward W. Sanderson under GLO contract number 417, dated August 24, 1881. Surveyor General record states: Set sandstone 15x9x6 ins 10 ins in ground for cor to secs 13,18,19 and 24, marked with 3 notches on N. and S. edges, from which:

- A Fir 30 ins dia brs N60°E, 16 lks. dist. marked T4S R29E S18 BT
- A Black Pine 8 ins dia brs N50°W, 22 lks. dist. marked T4S R28E S13 BT
- A Fir 8 ins dia brs S40°W, 28 lks. dist. marked T4S R28E S24 BT
- A Fir 15 ins dia brs S50°E, 19 lks. dist. marked T4S R29E S19 BT

Corner found by Frank W. Campbell under GLO contract number 507, dated June 28, 1884. Surveyor General record states: The established cor to secs 13,18,19 and 24. I obliterate the marks referring to R28E.

No record of subsequent monumentation found in Morrow County survey records.

Description of corner evidence found:

Found a sandstone 14x8x6 inches, firmly set with 3 grooves on North and South faces.

ORIGINAL BTS

- Found 30" diameter White Fir N60°E, 16 lks, dead, down and badly rotted with no marks visible.
- Found 17" diameter White Fir S50°E, 19 lks, live and vigorous with bark scribes visible.
- Found 18" diameter White Fir S40°W, 28 lks with blaze evident (Tree previously opened).
- Found 8" diameter Lodgepole Pine N50°W, 22 lks dead and down with blaze chopped out.

Distances to the original BTS are to the estimated face of blaze.

Description of monument and accessories I established to perpetuate the

original location of this corner: In placed of the found original corner stone, I set a 2 1/2" x 30" aluminum pipe with aluminum cap marked as shown, 28 inches in the ground, from which:

- New Bearing Trees:
 - A 9 inch diameter Western Larch bears N7°E, 22.48 feet marked X BT
 - A 9 inch diameter Western Larch bears S41°E, 45.25 feet marked T4S R29E S19 BT


Buried the original corner stone North and alongside of monument.

Painted a 6 inch red band around all BTS and attached bearing tree and land survey monument signs.


Set steel fencepost approximately 5 feet North with Land Survey Monument sign attached.

I hereby certify that the above corner point was perpetuated as hereon described on June 27, 1989.

Witness: Rick Robinson

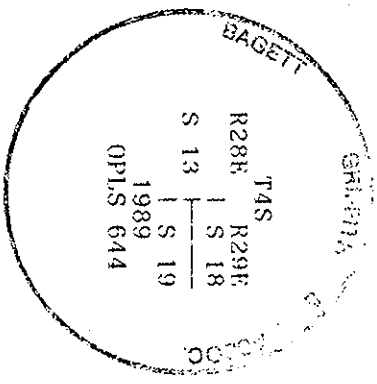

I used a steel tape and magnetic compass in the establishment of new accessories. I used 17° East magnetic declination and the distances are to a 50d spike driven in the right side of the root crown. I attached a brass washer marked O.P.L.S 644 to the BT blaze.

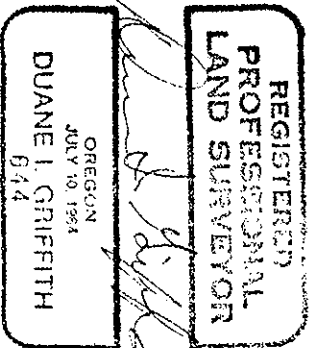

Office of..... County of.....
 State of..... I hereby certify that the within instrument was filed in this office
 for record on the..... day of....., 19.....

(COUNTY OFFICIAL)

(DEPUTY)

RECEIVED BY

Form R6-7100-57 (9/71)

Morrow County Surveyor

★ U.S. GOVERNMENT PRINTING OFFICE - 1983-793-276

1-10

N-01

8/24/89
WJG
 C-eee