

CERTIFIED RECORD OF LAND CORNER MONUMENTATION


K/- 11

History of original corner establishment:

Corner established in 1882 by Edward W. Sanderson, under General Land Office Contract No. 417.

Surveyor General's records state:

- A 9" fir marked 1/4 S on North Face for 1/4 corner.
- A fir 8 in. dia. br. 55° E, 22 lks. marked 1/4 S BT.
- A fir 12 in. dia. br. N45° W, 21 lks. marked 1/4 S BT.

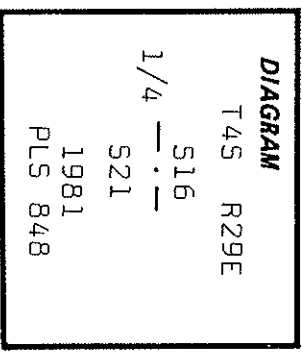

Description of corner evidence found:

Found rotten remains of fir, approx. 16 inches dia. A spring branch 68 ft. west as per original notes. An old mound of stone alongside fir (not of record) appears someone was perpetuating corner.

Found remains of rotten fir approx. 16 in. dia. Bears N45° W, 13.5 ft. (record 12" fir N45° W, 21 lks.) Found remains of fir stump, bears S15° E, 15.5 ft. (Record 55° E, 22 lks.) Accepted remains of fir described above as the 1/4 corner position.

Description of monument and accessories | established to perpetuate the original location of this corner:

Set 3"x30" galv. iron pipe with 3" brass cap, stamped as shown on the diagram. Set pipe 18 inches in the ground and raised a mound of stone and earth around pipe.


From which:
A fir 12 in. dia. bears N45° W, 13.6 ft. scribed 1/4 S 16 BT.
A fir 10 in. dia. bears 52° W, 12.3 ft. scribed 1/4 S 21 BT.
Set steel posts with warning and boundary signs 5 ft. East and 5 ft. West from corner.
Nailed bearing tree signs and brass washers stamped PLS 848 to each tree. Painted red band around each tree.

I hereby certify that the above corner monument was reestablished as herein described, on 10/5/81,

Witnesses:

Dan Martin

Dave Herbunger

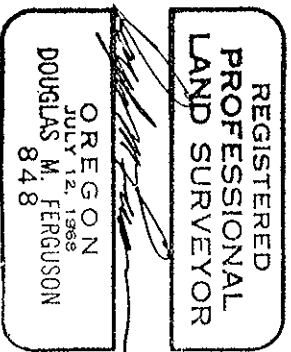

Office of C.O. Surveyor County of Umatilla
State of Oregon I hereby certify that the within instrument was filed in this office for record on the 7th day of January, 1982
by Barbara S. Hatfield (DEPUTY)

Form R6-7100-57 (9/71)

RECEIVED BY
Morrow County Surveyor
Date January 7, 1982
Rec'd By M. Hughes
No. 458-K
Pl. DWG. NO. C-4147-K

*GPO-798-276