


CERTIFIED RECORD OF LAND CORNER MONUMENTATION

History of original corner establishment: Corner established in 1882 by Edward W. Sanderson, under Contract No. 417.

Surveyor General Records State:

Set a sandstone 18x10x6 in. 12" in ground for corner to secs. 15, 16, 21 and 22 marked with 3 notches on S and E edges from which:

- A pine 36" in diam. brs. N. 25° E. 41 lks. dist. mkd T4S R29E S15 BT.
- A pine 36" in diam. brs. N. 42° W. 96 lks. dist. mkd T4S R29E S16 BT.
- A pine 20" in diam. brs. S. 60° W. 54 lks. dist. mkd T4S R29E S21 BT.
- A pine 24" in diam. brs. S. 45° E. 92 lks. dist. mkd T4S R29E S21 BT.

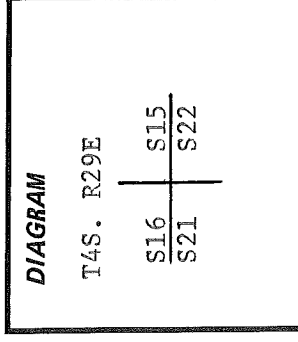

No record of subsequent remonumentation found in County Records.

Description of corner evidence found:

Found the original corner stone, a sandstone 14"x8"x7" set in a mound of stone, and marked with 3 notches on E edge, from which the ORIGINAL BEARING TREES:

- A 30" pine bears N. 24° E. 27.0 ft. mkd. T4S R29E BT.
- A 28" pine, dead and down bears N. 45° W. 64.0 ft. no mks. remain.
- A 20" pine bears S. 64° W. 34.1 ft. mkd with completely healed blaze.
- A 30" pine bears S. 49° E. 59.6 ft. with completely healed blaze.

Description of monument and accessories | established to perpetuate the original location of this corner:

At the corner point: Set a 2½"x30" galvanized iron pipe 5" in the ground with brass caps marked as shown: from which I scribe one NEW BEARING TREE:


A 12" fir bears N. 64° W. 22.6 ft. mkd. T4S. R29E S16 BT.

I nailed a brass washer marked "OPLS 598" to the BT blaze of this tree.


Set a steel fence post 5 ft. South of corner. Set original corner stone west of pipe. Raised mound of stone 3½ ft. base to within 4" of top of pipe. Used compass with 20° E. variation and steel tape measuring to center of new BTs and to face of blaze of old BTs.



Robert D. Baggett

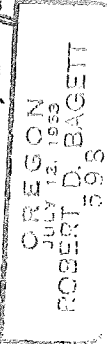

9-30-76

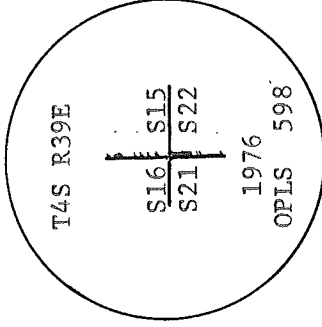

Office of..... County Surveyor..... Morrow
 State of..... Oregon..... County of.....
 for record on the..... day of....., 19.....

..... by..... (DEPUTY)
 (COUNTY OFFICIAL)