

CERTIFIED RECORD OF LAND CORNER MONUMENTATION

N-15

History of original corner establishment:

Corner established in 1882 by Edward W. Sanderson under General Land Office Contract No. 417. Surveyor General's records state:

DIAGRAM	
T 4S	R 29E
1/4	5 15
	5 22
	1981
	PLS 848

Set sandstone 15x12x4 ins. 10 ins. in ground for 1/4 Sec. Cor. marked 1/4 on N face.  
 From which  
 A pine 10 ins. dia. bears N5°E, 33 lks. dist. marked 1/4 S 8T.  
 A pine 9 ins. dia. bears S30°E, 25 lks. dist. marked 1/4 S 8T.

Description of corner evidence found:

Found 15"x12"x4" stone with 1/4 visible, set loosley in a mound of stone.  
 From which:  
 A pine 22 in. dia., dead, standing, bears N7°E, 24.0 ft. Blace grown over.  
 A pine 15 in. dia., live in good condition, bears S28°E, 16 ft., scribing visible, but illegible.  
 Accepted center of mound of stone as 1/4 cor. position.

Description of monument and accessories | established to perpetuate the original location of this corner:

Set 3"x30" galv. iron pipe with 3" brass cap stamped as shown on the diagram, set 20 inches in the ground and placed a mound of stone around pipe.  
 From which: *A Pine 15" dia. Bears N 60°E, 16.8 ft., scribed 1/4 S 15 8T*  
*A Pine 12" dia. Bears S 50°E, 18.5 ft., scribed 1/4 S 22 8T*


Set steel posts with warning and boundary signs 5 ft. East and 5 ft. West from corner.  
 Nailed bearing tree signs and brass washers stamped PLS 848 to each tree.  
 Painted red band around each tree.

I hereby certify that the above corner monument was reestablished as herein described, on 9/15/81.

Witnesses

Jeff Smith

Larry Willie

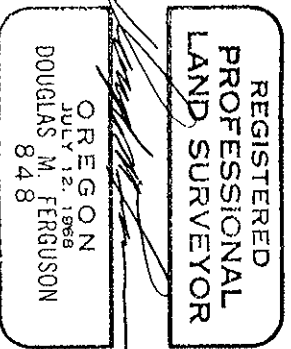

Office of CO. Surveyor ..... County of Umatilla  
 State of Oregon ..... I hereby certify that the within instrument was filed in this office  
 for record on the 27<sup>th</sup> day of January ..... 1982  
David Pradham (COUNTY OFFICIAL) Scott Shedd (DEPUTY)

Form R6-7100-57 (9/71)

RECEIVED BY

★ GPO—798-276

Morrow County Surveyor

Date January 7, 1982

Rec'd By M. Hughes

No. 453-K