

CERTIFIED RECORD OF LAND CORNER MONUMENTATION

N-19

History of original corner establishment:

Corner established in 1882 by Edward W. Sanderson under General Land Office Contract No. 417.

Surveyor General's records state:

Set basalt stone 12x12x4 ins. 8 ins. in ground for 1/4 Sec. Cor. marked 1/4 on North face.

From which

A pine 8 ins. dia. bears N10°W, 33 lks. dist. marked 1/4 S BT.

A pine 9 ins. dia. bears S20°E, 13 lks. dist. marked 1/4 S BT.

DIAGRAM	
T45	R29E
5	14
<hr/>	
1/4	S 23
	1981
	PLS 848

Description of corner evidence found:

Found 12"x12"x4" stone, when set upright, has 1/4 on North face.
From which:

A pine 20 in. dia., live in good condition, blaze grown over, bears N10°W, 18.2 ft.

A pine 22 in. dia., dead, standing, blaze grown over, bears S20°E, 10.4 ft.

Accepted center of stone when set upright as the 1/4 corner position.

Description of monument and accessories I established to perpetuate the original location of this corner:

Set 3"x30" galv. iron pipe with 3" brass cap stamped as shown in the diagram, set 22 inches in the ground. Placed original stone East alongside pipe.

From which:

A new bearing tree, a pine 13 in. dia. bears S58°W, 55.6 ft. scribed 1/4 S 23 BT.

The original tree, a pine 20 in. dia. bears N10°W, 18.2 ft. new scribing 1/4 S 14 BT.

Set steel posts with warning and boundary signs 5 ft. East and 5 ft. West from corner.


Nailed bearing tree signs and brass washers stamped PLS 848 to each tree. Painted a red band around each tree.

I hereby certify that the above corner monument was reestablished as herein described, on 9/3/81,

Witnesses

Mike Wpodward

Larry Wyllie

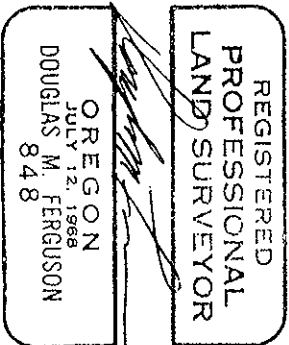

REGISTERED
PROFESSIONAL
LAND SURVEYOR
OREGON
JULY 12, 1968
DOUGLAS M. FERGUSON
848

Office of C.D., Surveyor..... County of...Umatilla.....

State of.....OREGON..... I hereby certify that the within instrument was filed in this office

for record on the 15 day of January, 1982.

Witnessed by Douglas M. Ferguson by Billy Skaff
(COUNTY OFFICIAL) (DEPUTY)

Form R6-7100-57 (9/71)

RECEIVED BY

Morrow County Surveyor

Date January 7, 1982

Rec'd BY M. Hughes

-No. 452-K

See Dr. G. M. C-47-n