


CERTIFIED RECORD OF LAND CORNER MONUMENTATION

N-23

History of original corner establishment:

Corner established in 1882 by Edward W. Sanderson under General Land Office Contract No. 417. Surveyor General's records state:
 Set basalt stone 12x8x4 ins. 8 ins. in gr. for 1/4 Sec. Cor. marked 1/4 on N face.
 From which
 A fir 8 ins. dia. bears S35°W 31 lks. dist. marked 1/4 S BT.
 A fir 18 ins. dia. bears N45°E 21 lks, dist. marked 1/4 S 8t.

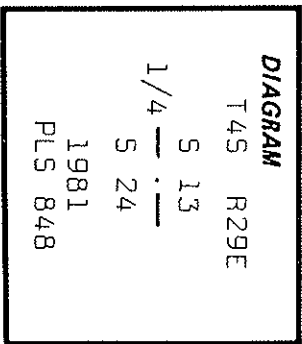

Description of corner evidence found:

Original stone not found. The original surveyor apparently measured 1/2 mi. East and set the corner, as the Section 13 is badly distorted.

At a point which is harmonious to call to creek West and fits the record calls from a fir 20 in. dia., live, I opened blaze, growth rings indicate tree to be the proper age, axe marks on blaze, bears S35°W, 20 1/2 ft. The rotten remains of a fir bears N45°E, approx. 14 ft. Accepted point as corner position.

Description of monument and accessories I established to perpetuate the original location of this corner:

Set 3"x30" galv. iron pipe with 3" brass cap stamped as shown on the diagram, set 20 inches in the ground and placed a ring of stone around the pipe.
 From which
 A fir 10 inches dia. bears N72°E, 21.7 ft. scribed 1/4 S 13 BT.
 A fir 9 inches dia. bears S16°E, 16.6 ft. scribed 1/4 S 24 BT.
 Set steel posts with warning and boundary signs 5 ft. North and 5 ft. West from corner.
 Nailed bearing tree signs and brass washers stamped PLS 848 to each tree.
 Painted red band around each tree.

I hereby certify that the above corner monument was reestablished as herein described, on 9/10/81.

**REGISTERED
 PROFESSIONAL
 LAND SURVEYOR**

OREGON
 JULY 12, 1968
 DOUGLAS M. FERGUSON
 848

Witnesses: Mike Woodward
Jeff Smith

Office of..... Co. Surveyor..... Umatilla
 Oregon
 State of..... I hereby certify that the within instrument was filed in this office
 for record on the 7th day of January, 1982
David M. Mullan by Patricia Mullan
 (COUNTY OFFICIAL) (DEPUTY)

RECEIVED BY
 Morrow County Surveyor
 Date January 7, 1982
 Rec'd By M. Hughes
 No. 449-K
 KEY. DIVISION E197-K