


CERTIFIED RECORD OF LAND CORNER MONUMENTATION

U-7

History of original corner establishment:

Corner originally established in 1882 by Edward W. Sauderson under General Land Office Contract No. 417. Corner was re-monumented in 1976 by PLS 598. Refer to that monumentation record.

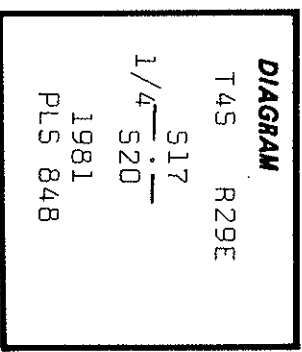

Description of corner evidence found:

Recently remonumented corner has been destroyed by logging.

Recently established bearing trees are in good condition; therefore, I reset the monument from the new bearing trees.

Refer to records for this corner remonumented by PLS 598 in 1976.

Description of monument and accessories | established to perpetuate the original location of this corner:

Set 3"x30" galv. iron pipe with 3" brass cap, stamped as shown on the diagram. Set pipe 22 inches in the ground and placed a circle of stone around pipe.


From which:
New bearing trees as established by PLS 598 in 1976;
refer to that monumentation record.

I hereby certify that the above corner was reset as herein described, on 10/5/81.

Witnesses:

Dan Martin

Dave Herburger

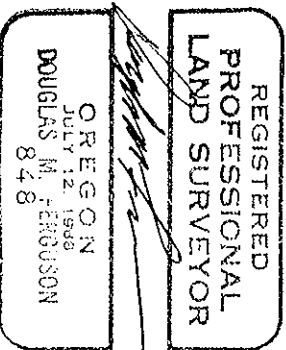

Office of..... Co. Surveyor..... County of..... Umatilla
 State of... Oregon..... I hereby certify that the within instrument was filed in this office
 for record on the...7th day of...January....., 1982
 by...David Adam Beck..... by...Stacy Shaver.....
 (COUNTY OFFICIAL) (DEPUTY)

Form R6-7100-57 (9/71) RECEIVED BY Morrow County Surveyor *OPO-798-276

Date JANUARY 7, 1982
 Rec'd By M. Hughes
 No. 457-K
 701 NW 1/4 Sec 10, T4S, R29E