

CERTIFIED RECORD OF LAND CORNER MONUMENTATION

History of original corner establishment:


1882 RECORD: Surveyed by E.W. Sanderson under GLO Contract #417
40.00 set sandstone 18x12x3 ins. 12 ins. in ground for 1/4 sec. cor. marked 1/4 on W. face from which a fir 8 in. dia. bears S.40°W. 8 lks. dist. marked 1/4 S. B.T. A fir 6 ins. dia. bears N.60°E. 7 lks. dist. marked 1/4 S. B.T.

45.50 A fir 30 ins. dia. on line

1885 RECORD: Retraced by Campell under GLO contract 507

Resurvey of the east boundary of T4S, R28E made this a corner controlling S 19 only.

51.13: The established 1/4 section corner on the W boundary of Section 19

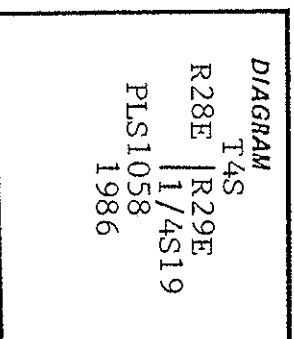

Description of corner evidence found:

Found sandstone 20 x 12 x 4 inches loosely set 12" above ground. 1/4 marks visible on west face.

-29" douglas fir bears S.60°E. 9.9 feet, face previously chopped into - no marks visible.

We open another section of the face and find no marks.

-9" white fir bears S.10°W. 3.8 feet, 30" scar and 1932 K. tag (no bearings or dist.) face to stone.

-14" fir dead and down bears N.40°E. 9.8 feet. No marks found.

-38" fir stump (tied with compass and topofil) bears north 362.5 feet and is probable record line tree.

Corner is approximately 40 feet S.W. of road 5325.

Description of monument and accessories | established to perpetuate the original location of this corner:

1986: @ position of found stone set 3 1/4" PCI alum. cap on 2 1/2" x 30 alum. pipe 28" in the ground. Bury original stone on north side of monument.

-12" douglas fir bears S. 26° E., 29.3 feet. Marked 1/4 S19 BT
- 8" douglas fir bears N. 90° W., 23.6 feet. Marked 1/4 S19 BT

T4S
R28E | R29E
| 1/4 S 19
PLS 1058
1986

54-3, and 54-9 or 54-4 signs on all bearing trees. Trees have red band and blazes are painted red. Brass washer nailed to BT portion of blaze on new bearing trees and on old bearing trees if needed. Steel guard post with 54-9 or 54-4 sign set 0 to 6 feet from corner. Distance measured in horizontal feet to center of tree. Bearings measured with magnetic compass, 20° East declination.

CERTIFICATION

I, Ken E. Jenkins
certify the information shown herein is true and correct.

REGISTERED
PROFESSIONAL
LAND SURVEYOR

Thomas M. Hanson
Signed and Sealed as Party Chief
certify that the work performed
by me or under my direct supervision
conforms to the standards of the
Professional Surveyors work performed
under the laws of the State of Oregon

OREGON
JUNE 18, 1976
THOMAS M. HANSON
EMPLOYER
1986

7-86
PROFESSIONAL CONSULTANTS

State of... *Oregon*... I hereby certify that the within instrument was filed in this office
for record on the... day of... *November*... 1986.
David H. K. Jones by... (DEPUTY)