

CERTIFIED RECORD OF LAND CORNER MONUMENTATION

R-14

DIAGRAM

T4S R29E
<u>S 22</u>
S 27
W 1/16 Cor.

History of original corner establishment:

Corner not established in the original survey of 1882 by Edward W. Sanderson

No record of subsequent monumentation was found in county records.

Description of corner evidence found:

(See map of Survey, dated September, 1975.)


Description of monument and accessories established to perpetuate the original location of this corner

At corner position, I set 2½" x 30" iron pipe with brass cap marked as shown, 29" in ground, from which:


A 10" L.P. Pine bears S 54 E., 25.6 ft. marked W 1/16 S 27 BT

A 8" L.P. Pine bears N 66 W., 9.0 ft. marked W 1/16 S 22 BT.

Set steel fence post 5½ ft. East and South of corner.

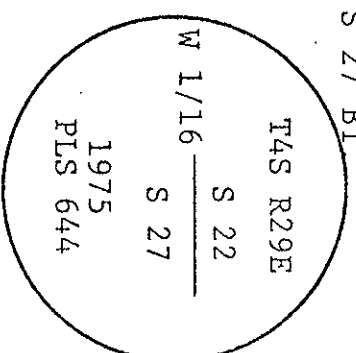

Brass washer nailed to BT. blaze,
 Used steel tape and magnetic compass
 with 20° East declination.
 Measured to center of all BTs.

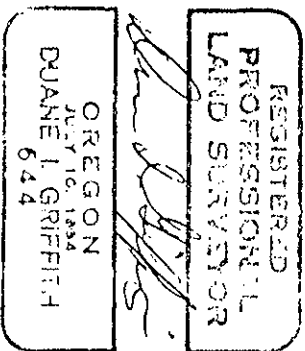

Office of County of

State of, I hereby certify that the within instrument was filed in this office
 for record on the day of

..... by
 (COUNTY OFFICIAL) (DEPUTY)

#361-K

#361-K