

CERTIFIED RECORD OF LAND CORNER MONUMENTATION

R-21

DIAGRAM

T4S R29E	
S 23	S 24
S 26	S 25

History of original corner establishment:

Corner established in 1882 by Edward W. Sanderson under General Land Office, Contract No. 417  
 Surveyor General Record states:

Set basalt stone 15 x 13 x 3 for cor. to Sects. 23-24-25-26 marked with 2 notches on South and 1 notch on East edges from which:

A Fir, 8 ins. dia. bears N. 10 E., 41 lks.  
 A Fir, 9 ins. dia. bears N. 75 W., 19 lks.  
 A Fir, 6 ins. dia. bears S. 30 W., 38 lks.  
 A Fir, 30 ins. dia bears S. 60 E., 12 lks.

No record of subsequent remonumentation was found in county records.

Description of corner evidence found:

Fd. stone 32 x 13 x 3, with notches, firmly set, from which:


A 30"± Fir, dead, down, badly rotted, bears S. 60 E., 7.5ft. scribes visible.  
 A 16 " Fir, live, bears N. 72 W., 12.7 ft. No scribes visible. Did not open.  
 A stump hole bears N. 11 E., 27ft. ft.  
 A 15" Fir, vigorous, bears S. 29 W., 24.7 ft., showed no evidence of original blaze--I opened this tree and found scribes as recorded.

(See map of Survey, dated September, 1975.)


Description of monument and accessories established to perpetuate the original location of this corner

In position of stone I set 2½" x 30" iron pipe with brass cap marked as shown, 26" in ground, from which:

New Bts  
 A 28" P. Pine bears N. 30 E., 63.1 ft., marked T4S R29E S 24 BT.  
 A 10" Fir bears S. 58 E., 35.2 ft., marked T4S R29E S 25 BT.  
 A 17" Fir bears S. 63 W., 33.0 ft., marked T4S R29E S 26 BT.  
 A 16" Fir bears N. 79 W., 22.0 ft., marked T4S R29E S 23 BT.  
 Buried stone North and alongside pipe. Set steel fence post 5t ft. North of Corner

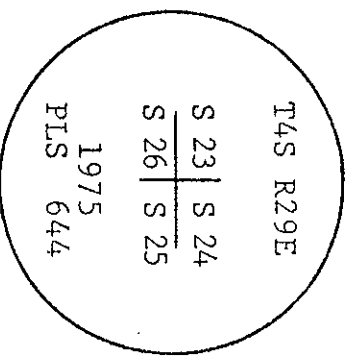

Brass washer nailed to BT. blazes,  
 Used steel tape and magnetic compass  
 with 20 East declination.  
 Measured to center of all Bts.

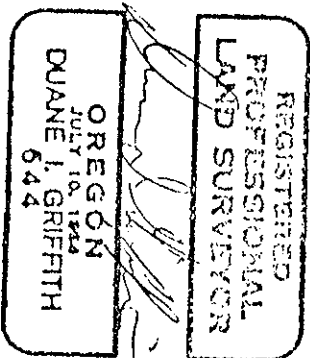

Office of ..... County of .....  
 State of ....., I hereby certify that the within instrument was filed in this office  
 for record on the ..... day of .....  
 (COUNTY OFFICIAL) ..... by ..... (DEPUTY)

#341-K

#341-K