


CERTIFIED RECORD OF LAND CORNER MONUMENTATION

History of original corner establishment:

1882 RECORD: Cor. estab. in 1882 by E.W. Sanderson, GLO Contract No. 417 80.00 A point 350 feet below 1/4 section corner. Marked A tamarack 10 ins. dia., for corner to sections 19, 20, 29, 30 marked: T4S S20 on N.E., R29E, S29 on SE., S 30 on SW and S19 on NW face with 2 notches on S and 5 notches on E edges.

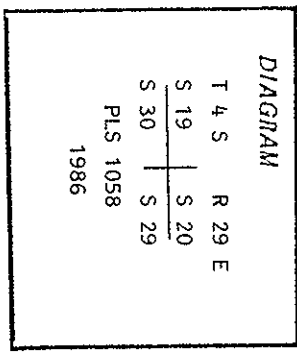

From which:
A tamarack 12 in. dia., bears N. 30° E., 27 lks. dist., marked T4S R29E S20 BT
A tamarack 12 ins. dia., bears N. 60° W., 21 lks. dist., marked T4S R29E S19 BT
A tamarack 9 ins. dia., bears S. 65° W., 25 lks. dist., marked T4S R29E S30 BT
A tamarack 11 ins. dia., bears S. 70° E., 7 lks. dist. marked T4S R29E S29 BT

Description of corner evidence found:

Found 14 inch rotten stump for record corner tree, broke off at ground level. No useable evidence of tree found besides stump.

14 inch stump bears n. 30° E., 17.8 feet (no marks)
13 inch larch snag bears N. 60° W., 13.9 feet marked: T4S R29E S19 BT
12 inch stump bears S. 70° E., 4.6 feet (no marks)

Description of monument and accessories I established to perpetuate the original location of this corner:

Use distance intersect from 3 found original bearing trees. The point for corner falls in rotted stump of original corner tree. At this point set 3-1/4 inch PCI aluminum cap on 2-1/2 x 30 inch aluminum pipe 27 inches in the ground. Marked as shown above.

7 inch fir bears N. 40° W., 14.6 feet marked: T4S R29E S 19 BT.
5 inch fir bears N. 12° E., 14.6 feet marked: X BT
6 inch L.P. pine bears S. 86° E., 22.5 feet marked: T4S R29E S29 BT
5 inch fir bears S. 63° W., 8.8 feet marked: X BT
600 feet South to Road 5326

54-3, and 54-9 or 54-4 signs on all bearing trees. Trees have red band and blazes are painted red. Brass washer nailed to BT portion of blaze on new bearing trees and on old bearing trees if needed. Steel guard post with 54-9 or 54-4 sign set 0 to 6 feet from corner. Distance measured in horizontal feet to center of tree. Bearings measured with magnetic compass, 20° East declination.

CERTIFICATION

I, Ken E. Jenkins, certify the information shown herein is true and correct.

REGISTERED PROFESSIONAL LAND SURVEYOR

Ken E Jenkins
Signature of Ground Party Chief
Thomas M. Hanson

Signature of Surveyor & Seal

OREGON
JUNE 18, 1976
THOMAS M. HANSON
10581 S

7-86 Reg. No. PLS 1058
PROFESSIONAL CONSULTANTS

State of.....Oregon....., I hereby certify that the within instrument was filed in this office
for record on the.....day of.....November....., 1986
.....Thomas M. Hanson..... by.....
(COUNTY OFFICIAL) (DEPUTY)