

CERTIFIED RECORD OF LAND CORNER MONUMENTATION

R-9

History of original corner establishment:

Corner established in 1882 by Edward W. Sanderson under General Land Office, Contract No. 417 Surveyor General Record states:

Set sand stone 15 x 12 x 5 ins. for cor. to Sects. 20-21-28-29, marked with 2 notches on S. and 4 notches on E. edges, from which:

DIAGRAM	
T4S	R29E
S 20	S 21
S 29	S 28
Witness Cor.	

- A Spruce, 10 ins. dia. bears N. 28 E., 31 lks.
- A Spruce, 15 ins. dia. bears N. 38 W., 20 lks.
- A Spruce, 30 ins. dia. bears S. 20 W., 27 lks.
- A Spruce, 26 ins. dia. bears S. 48 E., 24 lks.

No record of subsequent remonumentation was found in county records.

Description of corner evidence found:

Found NE BT--A 15" Spruce, dead & down, opened and found scribes.
 Found SE BT--A 30" Spruce, dead and down, scribes visible.
 Found remains of SW & NW BT, down and rotted out.
 Stone not found, it is on the edge of a creek.



(See map of Survey, dated September, 1975.)

Description of monument and accessories established to perpetuate the original location of this corner

At record bearings and distances from NE and SE BTs I locate true corner. This is in the edge of a creek and subject to erosion--I therefor set a witness corner N89° 40' 48"E, 26.00 ft. which is a 2½" x 30" iron pipe with brass cap marked as shown, 30" in ground, from which:

- A 8" Spruce bears N. 82 E., 26.0 ft. marked x BT.
- A 10" Fir bears S. 11 E., 16.3 ft. marked x BT.
- A 10" Spruce bears S. 1 W., 10.3 ft. marked x BT.
- A 8" Spruce bears N. 14 W., 57.6 ft. marked x BT.

Set steel fence post 5ft. West of witness corner.

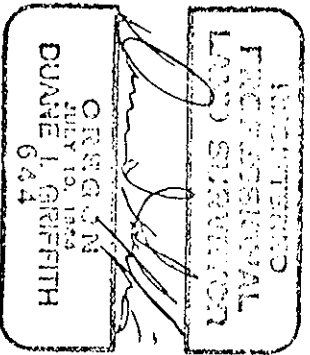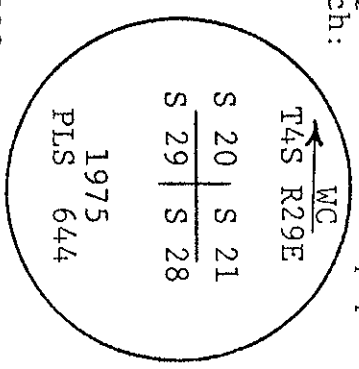

Brass washer nailed to BT. blazes,
 Used steel tape and magnetic compass
 with 20° East declination.
 Measured to center of all BTs.

Office of County of
 State of , I hereby certify that the within instrument was filed in this office
 for record on the day of
 (COUNTY OFFICIAL) by (DEPUTY)

#335-K

#335-K