

CERTIFIED RECORD OF LAND CORNER MONUMENTATION

T-12

DIAGRAM

T4S R29E

S 28

CE 1/16 Cor.

History of original corner establishment:

Corner not established in the original survey of 1882 by Edward W. Sanderson


No record of subsequent monumentation was found in county records.

Description of corner evidence found:


(See map of Survey, dated September, 1975.)

Description of monument and accessories established to perpetuate the original location of this corner

At corner position, I set 2½" x 30" iron pipe with brass cap marked as shown, 26" in ground, from which:
A 12" L.P. Pine bears S. 62 W., 31.9 ft. marked CE 1/16 S 28 BT.
A 12" L.P. Pine bears N. 24 W., 20.5 ft. marked CE 1/16 S 28 BT.
Set steel fence post 5+ ft. West and South of corner.

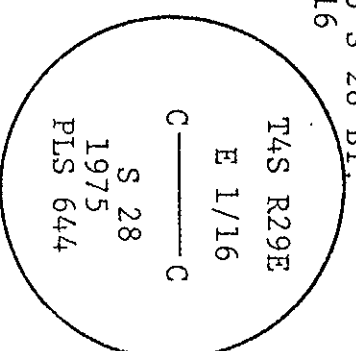

Brass washer nailed to BT. blaze,
Used steel tape and magnetic compass
with 20° East declination.
Measured to center of all BTs.

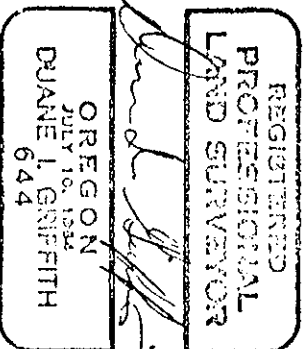

Office of..... County of.....
State of....., I hereby certify that the within instrument was filed in this office
for record on the..... day of.....
..... (COUNTY OFFICIAL) by..... (DEPUTY)

#352-K

#352-K