


CERTIFIED RECORD OF LAND CORNER MONUMENTATION

History of original corner establishment:

1975 RECORD:
At corner position, 1 set 2 1/2" x 30" iron pipe with brass cap marked as shown, 26" in ground, from which:
A 12" L.P. pine bears S. 62 W., 31.9 ft. marked CE 1/16 S 28 BT.
a 12" L.P. pine bears N. 24 W., 20.5 ft. marked CE 1/16 S 28 BT.

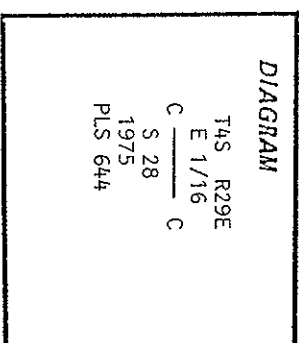

Description of corner evidence found:

Found 2 1/2 inch brass cap 2 inches above ground in 2 1/2 inch iron pipe. Marked as shown above.
6 ft. high stump bears S. 62° W., 31.9 feet marked CE 1/16 S28 BT.
6 ft. high stump bears N. 24° W., 20.5 feet marked CE 1/16 S28 BT.
Corner fall 150 feet east of unmarked dirt road, and in large clearcut.

Description of monument and accessories | established to perpetuate the original location of this corner:

7 inch fir bears S. 14° W., 100.3 feet marked CE 1/16 S 28 BT.
14 inch fir bears N. 27° W., 88.9 feet marked CE 1/16 S 28 BT.
54-3, and 54-9 or 54-4 signs on all bearing trees. Trees have red band and blazes are painted red. Brass washer nailed to BT portion of blaze, on new bearing trees. Steel guard post with 54-9 or 54-4 sign set 0 to 6 feet from corner. Distance measured in horizontal feet to center of tree. Bearings measured with magnetic compass, 20° East declination.

CERTIFICATION

I, Ken E. Jenkins
certify the information shown herein is true and correct.

Ken E. Jenkins
Signature: Chronid Party Chief
Thomas M. Manson
certify that this survey record correctly represents work performed by me or under my direction.
Thomas M. Manson
Signature: Thomas M. Manson

Date: 7-8-64 File # PR 4058
Employer: PROBATION CONSULTANTS

REGISTERED
PROFESSIONAL
LAND SURVEYOR

OREGON
JUNE 18, 1976
THOMAS M. MANSON
10581 S

State of Oregon I hereby certify that the within instrument was filed in this office
for record on the 11th day of November, 1966
David H. Blair by Thomas M. Manson
(COUNTY OFFICIAL) (DEPUTY)

[Handwritten Signature]