

CERTIFIED RECORD OF LAND CORNER MONUMENTATION

V-10

DIAGRAM

T4S R29E
S 28
S 33
W 1/16 Cor.

History of original corner establishment:  
Corner not established in the original survey of 1882 by Edward W. Sanderson


No record of subsequent monumentation was found in county records.

Description of corner evidence found:


(See map of Survey, dated September, 1975.)

Description of monument and accessories established to perpetuate the original location of this corner

At corner position, I set 2½" x 30" iron pipe with brass cap marked as shown, 27" in ground, from which:  
A. 10" Spruce bears N. 62 E., 20.6 ft. marked W 1/16 S 28 BT.  
A. 8" L.P. Pine bears S. 70 E., 42.8 ft. marked W 1/16 S 33 BT.  
Set steel fence post 5<sup>+</sup> ft. East of Corner.

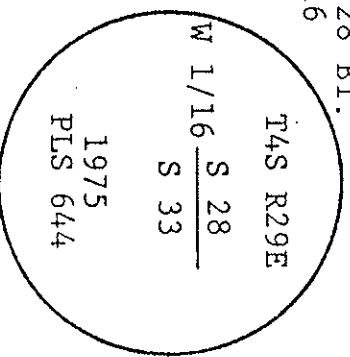

Brass washer nailed to BT. blaze,  
Used steel tape and magnetic compass  
with 20° East declination.  
Measured to center of all BTs.

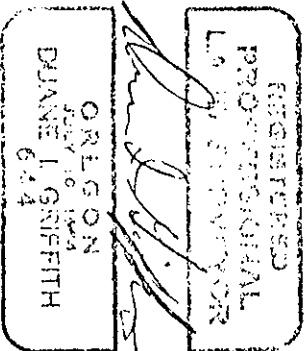

Office of ..... County of .....  
State of ....., I hereby certify that the within instrument was filed in this office  
for record on the ..... day of .....  
..... by .....  
(COUNTY OFFICIAL) (DEPUTY)

#349-K

#349-K