


CERTIFIED RECORD OF LAND CORNER MONUMENTATION

History of original corner establishment:
1975 Record:
At corner position, 1 set 2 1/2" x 30" iron pipe with brass cap marked as shown, 27" in ground, from which:
A 10" Spruce bears N.62 E., 20.6 ft. marked W 1/16 S 28 BT
A 8" L.P. Pine bears S. 70 E., 42.8 ft. marked W 1/16 S 33 BT.

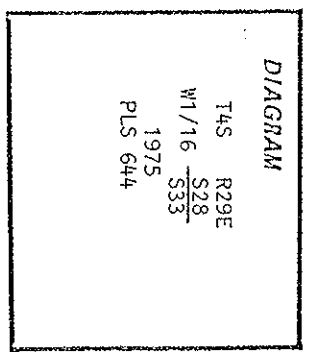

Description of corner evidence found:

- 2 1/2" brass cap 5" above ground on 2 1/2" iron pipe. Cap marked T4S R29E W1/16 S28 S33
13" spruce bears N. 62° E., 20.6 ft. partly healed face brass washer in place. 1975 PLS 644

Description of monument and accessories established to perpetuate the original location of this corner:


- 15" spruce bears S 51° E., 88.8 ft. marked W1/16 S 33 BT.
54-3, and 54-9 or 54-4 signs on all bearing trees. Trees have red band and blazes are painted red. Brass washer nailed to BT portion of blaze, on new bearing trees. Steel guard post with 54-9 or 54-4 sign set 0 to 6 feet from corner. Distance measured in horizontal feet to center of tree. Bearings measured with magnetic compass, 20° East declination.

Corner falls 40' west from unmarked dirt road.

CERTIFICATION

I, Ken F. Jenkins certify the information shown herein is true and correct.

Signature of Oregon Party Chief: Thomas M. Hanson
Signature of Surveyor & Seal: Thomas M. Hanson
Date: June 19, 1975
Employer: PROFESSIONAL CONSULTANTS

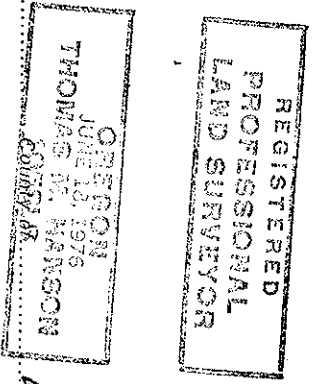

Office of... Surveyor... State of Oregon... I hereby certify that the within instrument was filed in this office for record on the... day of... 1986... David W. K... (COUNTY OFFICIAL) by... (DEPUTY)

Handwritten initials/signature