


CERTIFIED RECORD OF LAND CORNER MONUMENTATION

Index No. V-23

History of original corner establishment:

This corner was originally established by Edward W. Sanderson under Contract No. 417 dated August 24, 1881. The original notes state that at the corner a 9" black pine was marked for the corner from which:

- A 6" black pine bears North 4 Lks (2.6 ft) marked $\frac{1}{4}$ S BT.
- A 7" black pine bears S 25° E 7 Lks (4.6 ft) marked $\frac{1}{4}$ S BT.

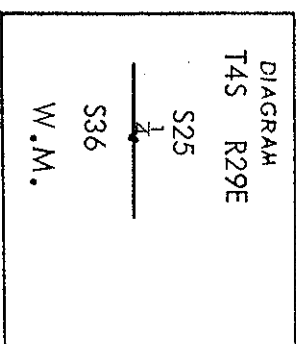

No record of subsequent remonumentation found in County Records .
Description of corner evidence found:

None - corner re-established by survey.

Description of monument and accessories established to perpetuate the original location of this corner

At the corner position a 2 inch by 30 inch iron pipe, with brass cap marked as shown, was set 30 inches in the ground in earth mound and trench.
 Set steel fence post by corner and attached sign 54-9.

Established 2 new BT's:

A 6 1/2" tamarack bears N 22 1/2° W, 45.3 feet scribed $\frac{1}{4}$ S25BT.

An 11 1/2" tamarack bears S 5 1/2° W, 24.8 feet scribed $\frac{1}{4}$ S36BT.

New BT's have a lower blaze scribed BT with a brass washer stamped PLS 1106 nailed flush. Attached signs 54-3 and 54-4 to all BT's and painted red ring around the trees above upper blaze.

Location poster is on east side of jeep trail in the bottom of a draw in lodge pole thicket 500' + west of corner.


Used steel tape and magnetic compass with 19 1/2° east declination. Measured to center of Bts.

See map of survey.

This corner set August 22, 1979

Witnesses: R. D. English
 B. J. Reynolds

REGISTERED PROFESSIONAL LAND SURVEYOR <i>William R. Wells</i> OREGON JULY 22, 1977 WILLIAM R. WELLS 1106

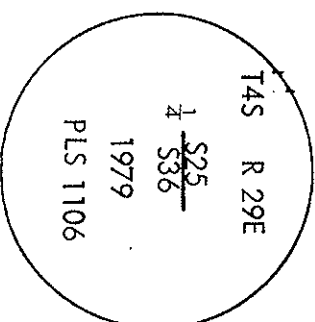

Office of County Surveyor Morrow County of Morrow
 State of Oregon, I hereby certify that the within instrument was filed in this office
 for record on the day of by (DEPUTY)
 (COUNTY OFFICIAL)

RECEIVED BY

Morrow County Surveyor

Date October 16, 1979

Rec'd By M. W. [Signature]

No. 255-4