


CERTIFIED RECORD OF LAND CORNER MONUMENTATION

History of original corner establishment:

1975 RECORD:  
In corner position, 1 set 2 1/2" x 30" iron pipe with brass cap marked as shown, 29" in ground, from which:  
A 8" L.P. pine bears N. 31 E., 16.2 ft. marked NW 1/16 S 33 BT.  
A 7" L.P. pine bears S. 14 W., 16.2 ft. marked NW 1/16 S 33 BT.

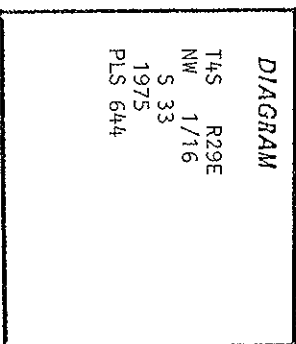

Description of corner evidence found:

Found 2 1/2 inch brass cap, flush with ground. Marked as shown above.  
12 inch L.P. pine bears N. 28° E., 16.2 feet, dist., marked NW 1/16 S33 BT.  
Dead 10 inch L.P. pine bears S. 11° W., 16.2 feet, marked NW 1/16 S33 BT.  
NOTE: We find 1975 record bearings 3° different. Brass washers on found BT's.  
Corner is 85 feet east from centerline of unmarked gravel road. Also is 294 feet north from centerline road no. 120.

Description of monument and accessories | established to perpetuate the original location of this corner:



10" L.P. pine bears S. 60° E., 29.5 feet marked NW 1/16 S 33 BT.  
54-3, and 54-9 or 54-4 signs on all bearing trees. Trees have red band and blazes are painted red. Brass washer nailed to BT portion of blaze, on new bearing trees. Steel guard post with 54-9 or 54-4 sign set 0 to 6 feet from corner. Distance measured in horizontal feet to center of tree. Bearings measured with magnetic compass, 20° East declination.

CERTIFICATION

I, Ken E. Jenkins  
certify the information shown herein is true and correct.

*Ken E. Jenkins*  
Signature of County Clerk  
Thomas M. Hanson  

*Thomas M. Hanson*  
Signature of Surveyor & Seal  
Date: 7-8-86 18 P.M. 058  
Employer: PROFESSIONAL CONSULTANTS

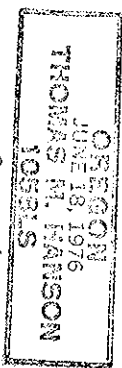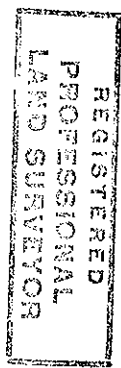

State of: Oregon, I hereby certify that the within instrument was filed in this office for record on the 18 day of November, 1986  
*David H. Keller*  
(COUNTY OFFICIAL) by (DEPUTY)

Form R6-7100-57 (9/71)

7600-798-278