

CERTIFIED RECORD OF LAND CORNER MONUMENTATION

History of original corner establishment: By Griffith in 1975:

At corner position, 1 set 2 1/2" x 30" iron pipe with brass cap marked as shown, 29" in ground, from which:

A 7" L.P. Pine bears N. 50 E., 37.7 ft., marked N 1/16 S 33 BT.

A 8" L.P. pine bears N. 73 W., 14.1 ft., marked N 1/16 S 32 BT.

DIAGRAM	
T4S	R29E
N 1/16	
S32 S33	
1975	
PLS 644	

Description of corner evidence found:

Found 2 1/2" BC flush with ground, marked:	T4S R29E
	N 1/16
	S32 S33
	1975
	PLS 644

9" L.P. pine bears N. 50° E., 31.7 feet, marked N 1/16 S 33 Bt. (Record Distance incorrect)

Dead 8" L.P. Pine bears N. 73° W., 14.1 feet, marked N 1/16 S 32 BT

Brass washers on found B.T.s.

Corner is at NW corner of clearcut. 560 feet East to Road 5326

Description of monument and accessories I established to perpetuate the original location of this corner:

8" fir bears N. 09° E., 42.5 feet marked N 1/16 S 33 BT


10" Larch bears S. 25° E., 48.4 feet marked N 1/16 S 33 BT

54-3, and 54-9 or 54-4 signs on all bearing trees. Trees have red band and blazes are painted red. Brass washer nailed to BT portion of blaze, on new bearing trees. Steel guard post with 54-9 or 54-4 sign set 0 to 6 feet from corner. Distance measured in horizontal feet to center of tree. Bearings measured with magnetic compass, 20° East declination.

CERTIFICATION

I, Ken E. Jenkins

certify the information shown herein is true and correct.

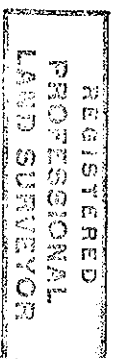

Ken E. Jenkins
 Signature, Ground LAY Chief
 Thomas M. Hanson
 certify that this Certificate of Registration was issued to me or under my direct supervision and that the work performed by me or under my direct supervision is in accordance with the laws of the State of Oregon.
 Date: 7-86
 Signature of Surveyor & Seal
 Thomas M. Hanson
 PROFESSIONAL CONSULTANTS

Office of..... *Surveyor* County of..... *Marion*
 State of..... *Oregon* I hereby certify that the within instrument was filed in this office
 for record on the..... day of..... *November*....., 19*86*
David H. Kinkaid
 (COUNTY OFFICIAL) by..... (DEPUTY)

DFJ
W-9