


CERTIFIED RECORD OF LAND CORNER MONUMENTATION

Index No. X-21

History of original corner establishment:

This corner was originally established by Edward W. Sanderson under Contract No. 417 dated August 24, 1881. The original notes state that at the corner an 18" x 10" x 4" marked sandstone was set 12" in the ground from which:
 A 15" tamarack bears S 85° W, 84 Lks (55.4 ft) marked $\frac{1}{4}$ S BT.
 A 16" pine bears S 30° E, 64 Lks (42.2 ft) marked $\frac{1}{2}$ S BT.

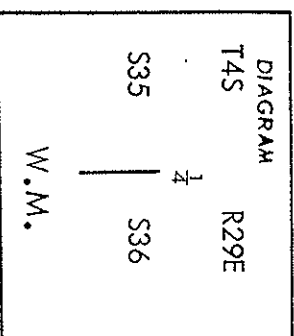

No record of subsequent remonumentation found in County Records .
Description of corner evidence found:

A 26" tamarack bears S 85° W, 55.4 feet with illegible scribing.
 A nearly obliterated stump hole bears S 30° E, 42 feet ±.

Description of monument and accessories established to perpetuate the original location of this corner


At the corner position a 2 inch by 30 inch iron pipe, with brass cap marked as shown, was set 20 inches in the ground and surrounded with a mound of stones to the cap.
 Set steel fence post by corner and attached sign 54-4.
 Established 2 new BT's:
 A 14 $\frac{1}{2}$ " tamarack bears S 61° E, 31.9 feet scribed $\frac{1}{4}$ S 36 BT.
 A 7" red fir bears S 32° W, 22.7 feet scribed $\frac{1}{4}$ S 35 BT.
 New BT's have a lower blaze scribed BT with a brass washer stamped PLS 1106 nailed flush. Attached signs 54-3 and 54-4 and painted a red ring around all BT's.
 Location poster located on north side of Western Route Road (on cattle guard) 1080' ± south of corner.

Used steel tape and magnetic compass with 19 $\frac{1}{2}$ ° east declination. Measured to center of Bts.
 See map of survey.

This corner set 8/23/79

Witnesses: R. D. English
 B. J. Reynolds

REGISTERED PROFESSIONAL LAND SURVEYOR
<i>William R. Wells</i>
OREGON JULY 22, 1977 WILLIAM R. WELLS 1106

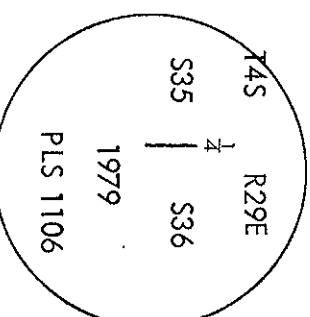

Office of County Surveyor County of Morrow
 State of Oregon, I hereby certify that the within instrument was filed in this office
 for record on the day of
 (COUNTY OFFICIAL) by (DEPUTY)

RECEIVED BY

Morrow County Surveyor

Form R6-7100-57 (9/71)

Date October 16, 1979
 Rec'd By M. Hughes
 No. 255-4