


CERTIFIED RECORD OF LAND CORNER MONUMENTATION

Index No. Y-22

History of original corner establishment:  
Corner not previously established.

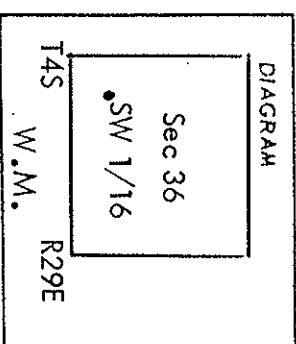

No record of subsequent remonumentation found in County Records .  
Description of corner evidence found:

None .

Description of monument and accessories 1 established to perpetuate the original location of this corner

At the corner position a 2 inch by 30 inch iron pipe, with brass cap marked as shown, was set 29 inches in the ground and surrounded with a mound of stones to the cap .

Set steel fence posts south and west of corner on property line and attached signs 54-2 and 54-9.

Established 2 new BT's:

A 6" lodge pole pine bears N71½°W, 14.2 feet, scribed SW 1/16 S36 BT .

A 6" lodge pole pine bears N33½°E, 19.55 feet, scribed SW 1/16 S36 BT .

New BT's have a lower blaze scribed BT with a brass washer stamped PLS 1106 nailed flush .

Attached signs 54-3 and 54-4 and painted a red ring around all BT's.

Location poster is located at the top of a fill on the south side of Western Route Road 110' ± north of corner .

Used steel tape and magnetic compass with 19½° east declination . Measured to center of Bts .

See map of survey .


This corner set October 2, 1979

Witnesses:  
Greg Flowers, LSIT  
B. J. Reynolds

REGISTERED  
PROFESSIONAL  
LAND SURVEYOR

*William R. Wells*

OREGON  
JULY 22, 1977  
WILLIAM R. WELLS  
1106

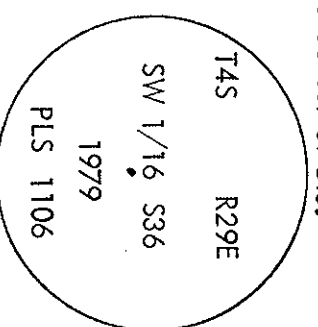

Office of ..... County Surveyor ..... County of ..... Morrow  
State of ..... Oregon ..... , I hereby certify that the within instrument was filed in this office  
for record on the ..... day of .....  
..... by ..... (DEPUTY)  
(COUNTY OFFICIAL)

**RECEIVED BY**

Morrow County Surveyor

Date October 16, 1979

Rec'd By M. Whigham

No. 255-4

Form R6-7100-57 (9/71)