


CERTIFIED RECORD OF LAND CORNER MONUMENTATION

History of original corner establishment: Corner established in 1882 by Edward W. Sanderson under Contract No. 417.

Surveyor General Records State:

Set sandstone 18x8x8 ins. 12 ins. in ground for 1/4 sec. cor. marked 1/4 on N. face from which:

A pine 36" in diam. brs. N. 57° E. 108 lks. dist. mkd. 1/2 S BT.
A fir 20" in diam. brs. N. 3° W. 50 lks. dist. mkd. 1/2 S BT.

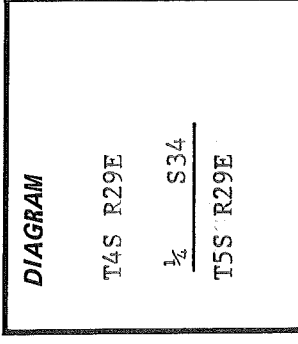

No record of subsequent remonumentation found in County Records.

Description of corner evidence found:

A did not find the original corner stone. I establish this corner at record distance from the original BTs from the corner point:

A 36" pine snag bears N. 54° E. 71.3 ft. no mks remain.
A 30" fir bears N. 16° W. 33.0 ft. mkd. 1/2 S BT in opened blaze.

Description of monument and accessories | established to perpetuate the original location of this corner:

At the corner point: Set 2 1/2"x30" iron pipe 25" in the ground with a brass cap marked as shown. From which I scribe NEW BEARING TREES:

A 16" pine bears N. 52° E. 25.7 ft. mkd. T4S R29E 1/4 S34 BT.
A 23" pine bears N. 60° W. 77.7 ft. mkd. X BT.

I nailed a brass washer marked "OPLS 598" to BT blaze on both trees. Set a steel fence post 5 ft. East of corner. Corner is 600 ft. North of road to Ellis G.S. Used compass with 20° E. variation and steel tape, measuring to center of BTs.


From the corner point: A basalt stone 8x8x8 ins. mkd. 1/4 and set in a md. of stone brs. East 109.5 ft. from this stone a 24" pine bears N. 55° E. 67.4 ft. mkd. 1/4 S in opened blaze, scribing has been cut in with pocket knife with blaze facing S 20° W.

REGISTERED
PROFESSIONAL
LAND SURVEYOR

Robert D. Baggett

OREGON
JULY 12, 1963
ROBERT D. BAGETT
598

Sept. 30, 1976

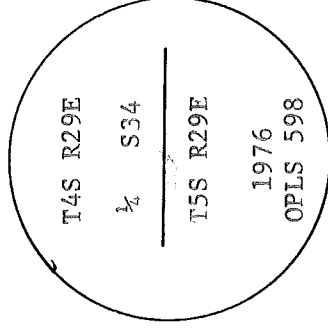

Office of..... County Surveyor..... County of..... Morrow
State of..... Oregon..... I hereby certify that the within instrument was filed in this office
for record on the..... day of....., 19.....
..... by..... (DEPUTY)
..... (COUNTY OFFICIAL)