

CERTIFIED RECORD OF LAND CORNER MONUMENTATION

Index No. Z-21

History of original corner establishment:

This corner was originally established by Edward W. Sanderson under Contract No. 417 dated August 24, 1881. The original notes state that at the corner a 4' long by 4" square marked wood post was set 24 inches in the ground for corner from which:

An 8" black pine bears N 35° W 30 Lks (19.8 ft) marked T4S R29E S 35 BT.
* A 9" black pine bears S 25° W 28 Lks (18.5 ft) marked T5S R29E S 2 BT.


* A 10" black pine bears S 40° E 19 Lks (12.5 ft) marked T5S R29E S 1 BT.
A 14" tamarack bears N 65° E 38 Lks (25.1 ft) marked T4S R29E S 36 BT.

* Note: Scribing on these BT's obliterated by Frank Campbell in 1883.

No record of subsequent remonumentation found in County Records .

Description of corner evidence found:

A 15" tamarack (down) bears N 65° E, 25.1 feet to stump hole scribed T4S R 29 E, S36.

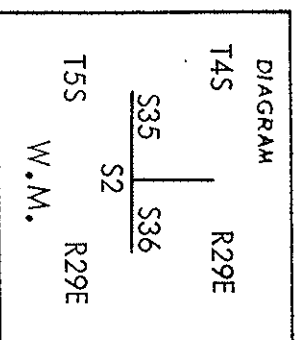

Description of monument and accessories established to perpetuate the original location of this corner

At the corner position a 2 inch by 30 inch iron pipe, with brass cap marked as shown, was set 29 inches in the ground with earth mound and trench.

Set steel fence posts north & east of corner & attached signs 54-2 & 54-4 to one post & sign 54-2 to other post.

Established 2 new BT's:

A 9" lodge pole pine bears N 19° E, 28.0 feet scribed T4S R29E S36 BT.
a 9½" spruce bears N 58° W, 53.4 feet scribed T4S R29E S 35 BT.

New BT's have a lower blaze scribed BT with a brass washer stamped PLS 1106 nailed flush.

Attached signs 54-3 and 54-4 to all BT's and painted red ring around trees above upper blaze.

Used steel tape and magnetic compass with 19½° east declination. Measured to center of Bts.
See map of survey .


This corner set August 22, 1979

Witnesses: R. D. English
B. J. Reynolds

REGISTERED
PROFESSIONAL
LAND SURVEYOR

Willie R. Wells

OREGON
JULY 22, 1977
WILLIAM R. WELLS
1106

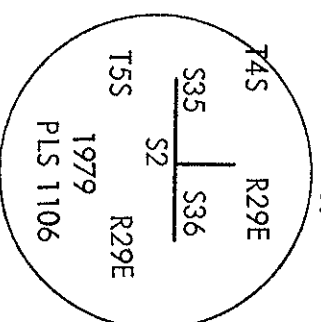

Office of _____ County Surveyor _____ County of Morrow _____
State of Oregon _____, I hereby certify that the within instrument was filed in this office
for record on the _____ day of _____ by _____ (DEPUTY)
(COUNTY OFFICIAL)

RECEIVED BY

Morrow County Surveyor

Date October 16, 1979

Rec'd By M. Hughes

No. 255-4

Form R6-7100-57 (9/71)