


CERTIFIED RECORD OF LAND CORNER MONUMENTATION

Index No. Z-23

History of original corner establishment:

This corner was originally established by Edward W. Sanderson under Contract No. 417 dated August 24, 1881. At the corner a 9" diameter black pine was marked for the $\frac{1}{4}$ corner from which:
 An 8" black pine bears N 40° E 10 Lks (6.6 ft) marked $\frac{1}{4}$ S BT.
 A 10" black pine bears S 18° E 14 Lks (9.2 ft) marked $\frac{1}{4}$ S BT.

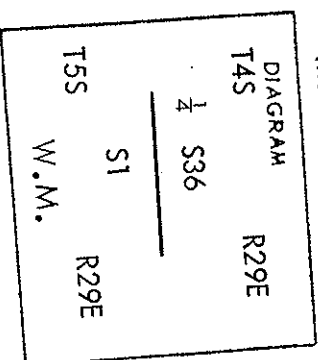

No record of subsequent remonumentation found in County Records .
 Description of corner evidence found:

None - corner set by survey.

Description of monument and accessories established to perpetuate the original location of this corner
 At the corner position a 2 inch by 30 inch iron pipe, with brass cap marked as shown, was set 26 inches in the ground with mound of earth and a trench.

Set steel fence post on township line by corner and attached sign 54-4.
 Established 2 new BT's:
 A 7" red fir bears N 27° W, 39.0 feet scribed $\frac{1}{4}$ S 36 BT.
 A 6 $\frac{1}{2}$ " red fir bears N 19° E, 15.0 feet scribed $\frac{1}{4}$ S 36 BT.
 New BT's have a lower blaze scribed BT with a brass washer stamped PLS 1106 nailed flush.
 Attached signs 54-3 and 54-4 to all BT's and painted red ring around the trees above upper blaze.

Used steel tape and magnetic compass with 19 $\frac{1}{2}$ ° east declination. Measured to center of Bts.
 See map of survey.

This corner set August 23, 1979.

Witnesses: R. D. English
 B. J. Reynolds

REGISTERED
 PROFESSIONAL
 LAND SURVEYOR
William R. Wells
 OREGON
 JULY 22, 1977
 WILLIAM R. WELLS
 1106

T4S R29E
 $\frac{1}{4}$ S36
 S1
 T5S R29E
 1979
 PLS 1106

Office of _____ County Surveyor _____ County of _____ MORROW
 State of Oregon, I hereby certify that the within instrument was filed in this office
 for record on the _____ day of _____ by _____ (DEPUTY)
 (COUNTY OFFICIAL)

RECEIVED BY

Morrow County Surveyor

Date October 16, 1979

Rec'd By M. Wheeler

No. 255-4