


**CERTIFIED RECORD OF LAND CORNER MONUMENTATION**

Index No. Z-25

**History of original corner establishment:**

The corner was originally established by Edward W. Sanderson under Contract No. 417 dated August 24, 1881. The notes state that at the corner, a 4½' long, 4" square marked pine post was set 2' in the ground on a slight N.E. slope for the corner from which:

- A 10" pine bears N62° E 19 lks (12.5 ft) mkd T4S R30E S31BT
- A 9" pine bears S34° E 21 lks (13.9 ft) mkd T5S R30E 56BT
- A 9" pine bears S68° W 32 lks (21.1 ft) mkd T5S R29E S1BT
- A 10" pine bears N44° W 8 lks (5.3 ft) mkd T4S R29E S36BT

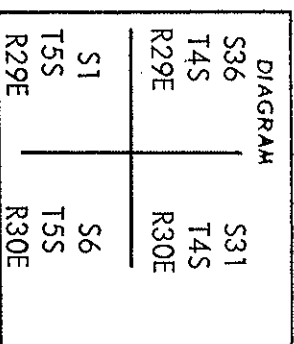

No record of subsequent remonumentation found in County Records .  
**Description of corner evidence found:**

- Found remains of the rotted original post buried in the ground.
- A dead and down tree bears N 62° E 12.5 ft + to stump hole with blaze rotted away.
- A down and completely rotted tree bears S 34° E 13.9 feet ±.
- A rotted stump buried under needles bears N 45° W 5.3 feet ±.
- Old line trees run north, south, east and west from the corner.

**Description of monument and accessories established to perpetuate the original location of this corner**

At the corner position a 2 inch by 30 inch iron pipe, with brass cap marked as shown, was set 29 inches in the ground/

Set steel fence post by corner and attached sign 54-4.

Established 4 new BT's:

- A 9½" red fir bears N8° E, 23.7 feet scribed T4S R30E S31BT.
- An 8½" red fir bears S31° E, 34.3 feet scribed T5S R30E S6BT.
- A 7" tamarack bears S54° W, 38.7 feet scribed T5S R29E S1BT.
- A 9" red fir bears N54½° W, 9.1 feet scribed T4S R29E S36BT.

New BT's have a lower blaze scribed BT with a brass washer stamped PLS 1106 nailed flush. Attached signs 54-3 and 54-4 to all BT's and painted red ring around the trees above upper blaze.

Location marker located on south side of road at top of cut bank 700 feet north of corner.

Used steel tape and magnetic compass with 19½° east declination. Measured to center of Bts.

See map of survey.


This corner set August 21, 1979

Witnesses: R. D. English  
 B. J. Reynolds

REGISTERED  
 PROFESSIONAL  
 LAND SURVEYOR

*William R. Wells*

OREGON  
 JULY 22, 1977  
 WILLIAM R. WELLS  
 1106

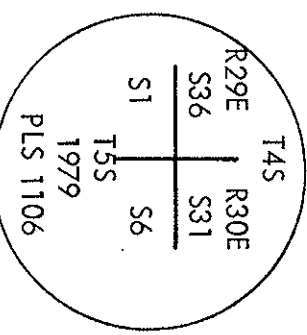

Office of County Surveyor Morrow County of Morrow  
 State of Oregon, I hereby certify that the within instrument was filed in this office  
 for record on the        day of        19        
 (COUNTY OFFICIAL) by        (DEPUTY)

**RECEIVED BY**

**Morrow County Surveyor**

Date October 16, 1979

Rec'd By M. Hubbard

No. 255-4