


CERTIFIED RECORD OF LAND CORNER MONUMENTATION

History of original corner establishment:

Corner established in 1882 by Edward W. Sanderson under General Land Office, Contract No. 417 Surveyor General Record states:

Marked A 9" Black Pine for corner. From which:

- 9" black pine bears N. 40° E., 18 lks.
- 9" black pine bears N. 50° W., 19 lks.
- 9" black pine bears S. 40° W., 15 lks.
- 8" black pine bears S. 35° E., 11 lks.

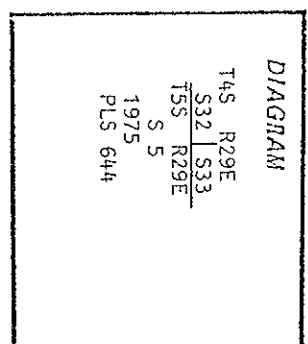

1975 RECORD:

At proportionate distance I set 2 1/2" x 30" iron pipe with brass cap marked as shown, 29" in ground, from which:

- New B's
- A 1 1/4" L.P. pine bears N. 14° E., 22.9 ft. marked T4S R29E S33 BT.
 - A 1 3/4" L.P. pine bears N. 81° W., 83.4 ft. marked T4S R29E S32 BT.

Description of corner evidence found:

Found 2" BC flush with ground marked

T4S	R29E
S32	S33
T5S	R29E
S5	
1975	
PLS 644	

Partly five 1 1/4" L.P. Pine bears N. 14° E., 22.9 ft. marked T4S R29E S33 BT.
 13" dead L.P. Pine bears N. 81° W., 83.4 ft. marked T4S R29E S32 BT
 Corner is at north side of rd. 53 and west of intersection with rd 5326.

Description of monument and accessories I established to perpetuate the original location of this corner:

No suitable accessories in Section 32
 7 inch L.P. Pine bears N. 29° E., 33.9 feet marked: T4S R29E S33 BT
 Northmost support post of U.S.F.S. Hanging sign (no sign 6-86) set brass wasger bears S.34° E., 64.1 feet.
 54-3, and 54-9 or 54-4 signs on all bearing trees. Trees have red band and blazes are painted red. Brass washer nailed to BT portion of blaze, on new bearing trees steel guard post with 54-9 or 54-4 sign set 0 to 6 feet from corner. Distance measured in horizontal feet to center of tree. Bearings measured with magnetic compass, 20° East declination.

CERTIFICATION

I, Ken E. Jenkins

certify the information shown herein is true and correct.

REGISTERED
 PROFESSIONAL
 LAND SURVEYOR

Ken E. Jenkins
 Ken E. Jenkins
 Registered Professional Land Surveyor

OREGON
 JUNE 13, 1976
 THOMAS W. HANSON
 105215

THOMAS W. HANSON
 Registered Professional Land Surveyor
 No. 105215
 State of Oregon
 My commission expires on 10/31/85
 CONSULTANTS

 State of Oregon I hereby certify that the within instrument was filed in this office
 for record on the day of November, 1986
David H. Kelly by
 (COUNTY OFFICIAL) (DEPUTY)

DFJ