

CERTIFIED RECORD OF LAND CORNER MONUMENTATION

C - 1 T4S R 30E
 DIAGRAM

History of original corner establishment:
 The original corner was established by Edward W. Sanderson on June 8, 1882, under GLO contract No. 417, as follows:
 Set a basalt stone, 18" x 12" x 8", 12" in ground for 1/4 section corner marked "1/4" on west face, from which:

T4S
R29E R30E
1/4
S1 S6
PLS 1636
2000

A 14" pine bears N42°E, 50 links (33.0 feet), marked "1/4S BT".
 A 14" pine bears N56°W, 34 links (22.44 feet), marked "1/4S BT".

Original corner evidence recovered:

Found the original corner stone solidly set on the east edge of a mound of stones. The corner stone is 22" x 10" x 7" and is plainly marked "1/4" on the west face, from which:

A 33" sawn Ponderosa Pine stump, 5 feet high, with scribes visible on the upper blaze, lower blaze healed, bears N42°E, 33.0 feet.

A sawn and decayed Ponderosa Pine stump with scribes, "BT", visible, bears N46°W, 22.4 feet.

Monument and accessories established to perpetuate the original position of this corner:

In place of the original corner stone, I set a 1" x 30" galvanized iron pipe 26" into the ground. A 2 1/2" brass cap attached to the pipe is marked as shown in the diagram above. I bury the corner stone along the south side of the pipe and build a mound of stones around the pipe, from which:

A 8" Ponderosa Pine, scribed "1/4S6 BT", bears N69°E, 54.0 feet.

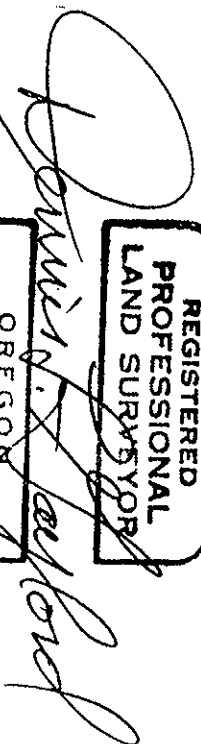
A 22" Ponderosa Pine, scribed "1/4S6 BT", bears S21°E, 40.6 feet.

A 12" Ponderosa Pine, scribed "1/4S1 BT", bears S39°W, 27.4 feet. This tree has a "Bearing Tree" sign nailed above the blazes.

A 17" Ponderosa Pine, scribed "1/4S1 BT", bears N72°W, 30.4 feet. This tree has a "Witness Post" sign nailed on the back.

The new bearing trees are scribed on double blazes and have a 3/4" brass washer, marked "PLS 1636", nailed to the scribed "B".

I hereby certify the above corner point was perpetuated as hereon described on August 4, 2000. Magnetic declination set in compass: 18°E.


 REGISTERED PROFESSIONAL LAND SURVEYOR
 OREGON
 JULY 14, 1978
 DENNIS L. GAYLORD
 1636

Renews June 30, 2001

Recorded at the office of County Surveyor, County of Umatilla, State of Oregon, on: